

CODED

MISSISSIPPI
BOARD OF WATER COMMISSIONERS
416 North State Street
Jackson, Mississippi 39201

CODED

WATER WELL DRILLERS LOG

Marshall
E10
6-69

June 25 1969 Bumpas well Co Marshall
date well completed firm name county well located

LANDOWNER:
Louise Lamb
P.O. # 2 Collinsville, Tenn
(mailing address)

description of formations encountered	from	to
	<u>clay sand</u>	<u>0</u>
	<u>10</u>	<u>100</u>

WELL LOCATION:
sec. 20 T 2 N R 4 E
6 miles north of Victory
(distance) (direction) (nearest town)

WELL PURPOSE:
(home, irrigation, municipal, industrial)

WELL COMPLETION DATA:

- (1) diameter (inches) 4"
- (2) total depth (feet) 103
- (3) static water level (feet) 70 below above top of ground
- (4) casing 4" 103
(material) (depth)
- (size) If telescope see back.
- (5) screen 7ft 103
(length) (depth to top)
- 4" gravel well
(size) (material)
- (6) pump 3/4 10
(HP) (yield gpm)
- (type power)
- (7) electric log (yes or no)
(organization running log)
- (8) how well bottom plugged 4' plug


CODED

AD 16 A 1969
MISS. Bd. OF
WATER COMM.

DRILLERS REMARKS:

If well telescopes please sketch and show depths.

GROUND LEVEL

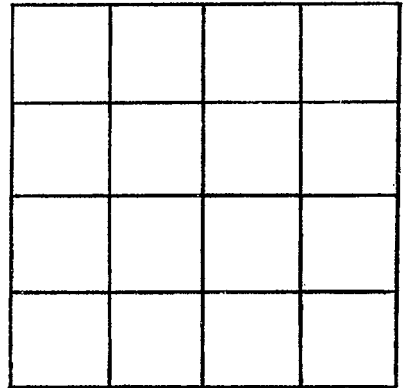

SECTION _____

Please indicate well location X.

ADDITIONAL INFORMATION

If more than one screen,
show locations of each on sketch.