

CODED

CODED

Marshall
E II
8-5-69

MISSISSIPPI
BOARD OF WATER COMMISSIONERS
416 North State Street
Jackson, Mississippi 39201

Re Curb Job

WATER WELL DRILLERS LOG

W.A. Mason, Water Well Contractor Marshall

August 5th, 1969
date well completed

firm name

county well located

LANDOWNER: Gordon Williams
Route 1
Byhalia Mississippi

description of formations
encountered

from

to

(mailing address)

WELL LOCATION:

sec. 30 T 2 N R 4 E
North Coal Oil Junction

2 miles (distance) of (direction) (nearest town)

WELL PURPOSE: present house
(home, irrigation, municipal, industrial)

Lonza Jones

WELL COMPLETION DATA:

- (1) diameter (inches) 5 in.
- (2) total depth (feet) 70
- (3) static water level (feet) 45 below top of ground.
- (4) casing (material) Styrene plastic (depth) 70

White medium coarse water bearing sand

CODED

If telescope see back.
(size) None

(5) screen (length) (depth to top)

(size) None (material)

(6) pump (HP) (yield gpm)

(type power)

(7) electric log (yes or no)

(organization running log) Not

(8) how well bottom plugged


AUG 12 1969

DRILLERS REMARKS:

MISS. BD. OF
WATER COM.

If well telescopes please sketch and show depths.

GROUND LEVEL

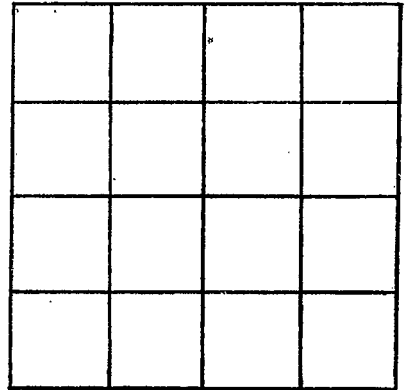

SECTION 30

Please indicate well location X.

R ADDITIONAL INFORMATION

ReCurbbed old 10' dia. 3 in.
wood curb well made by
Frank Shipp about 10 years
ago

If more than one screen,
show locations of each on sketch.