

Marshall
 E13
 7-23-69

MISSISSIPPI
 BOARD OF WATER COMMISSIONERS
 416 North State Street
 Jackson, Mississippi 39201

CODED

WATER WELL DRILLERS LOG

July 23 1969 R. L. Carpenter Marshall
 date well completed firm name county well located

LANDOWNER: John Falf
 Victoria, Miss
 RFD
 (mailing address)

description of formations encountered	from	to
Surface Soil	0	12
Med White Sand	12	35
White Clay	35	41
White Fine Sand	41	63
White Coarse Sand	63	85

WELL LOCATION:
 sec. 16 T. 2 N. R. 4 E
 S W
 4 miles northwest of Victoria
 (distance) (direction) (nearest town)

WELL PURPOSE: Home
 (home, irrigation, municipal, industrial)

WELL COMPLETION DATA:

(1) diameter (inches) 4 in
 (2) total depth (feet) 85
 (3) static water level (feet) 30 below top of ground.
 (4) casing Plastic, 79 ft.
 (material) (depth)
 (size) If telescope see back.
 (5) screen 6 ft, 79 ft
 (length) (depth to top)
 4 in, Plastic + gravel
 (size) (material)
 (6) pump 1/4 10
 (HP) (yield gpm)
 Elec.
 (type power)
 (7) electric log No
 (yes or no)
 (organization running log) Plastic
 Clay
 (8) how well bottom plugged

CODED


DRILLERS REMARKS:

MISSISSIPPI BOARD OF WATER COMMISSIONERS

If well telescopes please sketch and show depths.

GROUND LEVEL

R4a

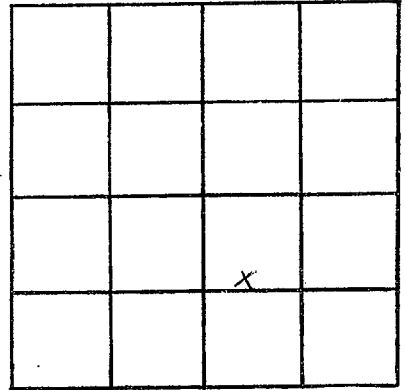

SECTION 16

Please indicate well location X.

ADDITIONAL INFORMATION

If more than one screen, show locations of each on sketch.