

Marshall
 E14
 7-31-69

MISSISSIPPI
 BOARD OF WATER COMMISSIONERS
 416 North State Street
 Jackson, Mississippi 39201

CODED
CODED

WATER WELL DRILLERS LOG

July 31 1969 R. L. Carpenter Marshall
 date well completed firm name county well located

LANDOWNER: Charles Stewart
 Victoria, Miss.
 RFD
 (mailing address)

description of formations encountered	from	to
Surface Soil	0	10
White coarse sand	10	27
Med white sand	27	42
White clay & white fine sand	42	60
White coarse sand	60	85

WELL LOCATION:
 sec. 20 T 2 N R 4 E
 4 miles southwest of Victoria
 (distance) (direction) (nearest town)

WELL PURPOSE: Home
 (home, irrigation, municipal, industrial)

WELL COMPLETION DATA:

(1) diameter (inches) 4 in.
 (2) total depth (feet) 85
 (3) static water level (feet) 30 below top of ground.
 (4) casing Plastic, 79 ft. (material) (depth)
 (size) if telescope see back.
 (5) screen 6 ft. 79 ft. (length) (depth to top)
 4 in. Plastic & Shovel (size) (material)
 (6) pump 3/4 HP 10 (yield gpm)
 Etc. (type power)
 (7) electric log No (yes or no)
 (organization running log) Plastic Plug
 (8) how well bottom plugged

CODED

SEP 17 1969


MISSISSIPPI BOARD OF WATER COMMISSIONERS

DRILLERS REMARKS:

If well telescopes please sketch and show depths.

GROUND LEVEL

R4W

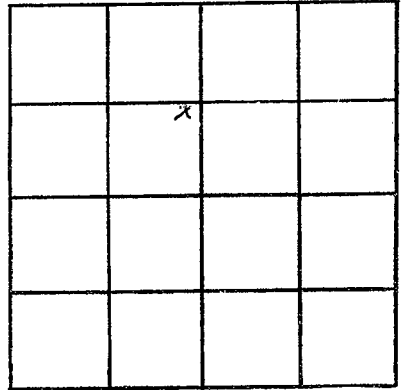

SECTION 20

Please indicate well location X.

ADDITIONAL INFORMATION

If more than one screen, show locations of each on sketch.