

MISSISSIPPI
BOARD OF WATER COMMISSIONERS
416 North State Street
Jackson, Mississippi 39201

CODED
CODED

WATER WELL DRILLERS LOG

Mar 27 1970 date well completed
Wilson Well Co firm name
Marshall county well located

LANDOWNER: <u>Walt Gammus</u>	description of formations encountered	from	to
<u>Memphis Term</u> (mailing address)	<u>Clay</u>	<u>0</u>	<u>15</u>
	<u>Brown Sand</u>	<u>15</u>	<u>60</u>
	<u>White Sand</u>	<u>60</u>	<u>120</u>

WELL LOCATION:
7 sec 20 T 20 N 2 R 4 E 4 miles North of Baylage
(distance) (direction) (nearest town)

WELL PURPOSE: Home
(home, irrigation, municipal, industrial)

WELL COMPLETION DATA:

- (1) diameter (inches) 4
- (2) total depth (feet) 130
- (3) static water level (feet) 50 below top of ground.
- (4) casing Plastic, 130 (material) (depth)
- (size) If telescope see back.
- (5) screen 10, 120 (length) (depth to top)
- 4, Plastic (size) (material)
- (6) pump 10 (HP) (yield gpm)
- Elect (type power)
- (7) electric log _____ (yes or no)

(organization running log)

(8) how well bottom plugged cap

DRILLERS REMARKS:


CODED

JAN - 5 1970

MISSISSIPPI
STATE BOARD OF WATER COMMISSIONERS

If well telescopes please sketch and show depths.

GROUND LEVEL

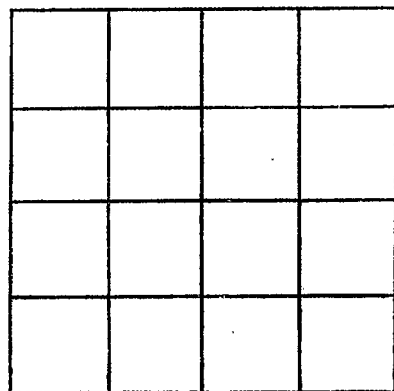

SECTION _____

Please indicate well location X.

ADDITIONAL INFORMATION

If more than one screen,
show locations of each on sketch.