

Marshall
E 18
10-8-69

MISSISSIPPI
BOARD OF WATER COMMISSIONERS
416 North State Street
Jackson, Mississippi 39201

CODED

WATER WELL DRILLERS LOG

Oct. 18 1969 R. L. Caperton Marshall Co.
date well completed firm name county well located

LANDOWNER: Hony Lee Moore
Red Banks, Miss
RFD
(mailing address)

description of formations encountered	from	to
<u>Surface Soil</u>	<u>0</u>	<u>18</u>
<u>Med & Coarse Red Sand</u>	<u>18</u>	<u>60</u>
<u>White Clay</u>	<u>60</u>	<u>82</u>
<u>Med & Fine white sand</u>	<u>82</u>	<u>101</u>
<u>White sand</u>	<u>101</u>	<u>125</u>

WELL LOCATION:
sec. 36 T. 2 N. R. 4 E.
3 miles Northwest of Red Banks
(distance) (direction) (nearest town)

WELL PURPOSE: Home
(home, irrigation, municipal, industrial)

WELL COMPLETION DATA:

- (1) diameter (inches) 4 1/2 in
- (2) total depth (feet) 125
- (3) static water level (feet) 60 below above top of ground.
- (4) casing Plastic, 119 ft.
(material) (depth)
(size) if telescope see back.
- (5) screen 6 ft., 119 ft.
(length) (depth to top)
4 in., Plastic Ground
(size) (material)
- (6) pump 1/2, 7
(HP) (yield gpm)
Elec.
(type power)
- (7) electric log no
(yes or no)

CODED

(organization running log) Plastic Plug

(8) how well bottom plugged

MAR 10 1970


MISS. Bd. of
WATER COMMISSIONERS

DRILLERS REMARKS:

If well telescopes please sketch and show depths.

GROUND LEVEL

R4W

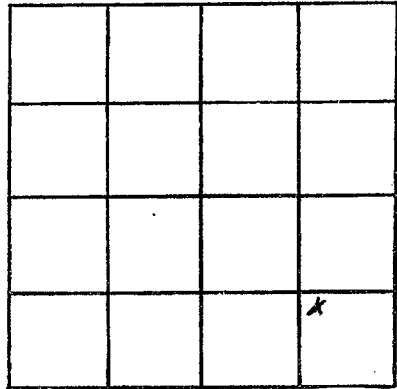

SECTION 36

Please indicate well location X.

ADDITIONAL INFORMATION

If more than one screen, show locations of each on sketch.