

Marshall  
E 19  
8-15-69

MISSISSIPPI  
BOARD OF WATER COMMISSIONERS  
416 North State Street  
Jackson, Mississippi 39201

**CODED**

WATER WELL DRILLERS LOG

8/15 1969 date well completed  
Shore Well Supply Co. firm name  
Marshall county well located

LANDOWNER: Frank Brewer  
Cayce, Miss  
4716 Lactaviles  
Memphis, Tenn. (mailing address)

description of formations encountered	from	to
Top soil	0	10
Med med sand	10	3.5
Med med	35	60
White fine sand + clay	60	9.5
White med sand	9.5	105
Brown med sand	105	115

WELL LOCATION: 156  
sec. 3 T. 22<sup>N</sup> R. 4<sup>E</sup>  
8 miles South of Collierville  
(distance) (direction) (nearest town)

WELL PURPOSE:  
MobiL (home) Irrigation, municipal, industrial

WELL COMPLETION DATA:

- (1) diameter (inches) 4"
- (2) total depth (feet) 115'
- (3) static water level (feet) 42' <sup>below</sup> above top of ground.
- (4) casing PVC(NSF), 107', (material), (depth)  
(size) If telescope see back.
- (5) screen 8' 107' (length) (depth to top)  
4" PIC Filter Pack (size) (material)
- (6) pump 1 25 (HP) (yield gpm)  
220 SP (type power)
- (7) electric log no (yes or no)

**CODED**

(organization running log)

(8) how well bottom plugged, end of screen 7" Cap


DRILLERS REMARKS:

APR - 8 1970

MISS. BD. OF WATER COMM.

If well telescopes please sketch and show depths.

GROUND LEVEL

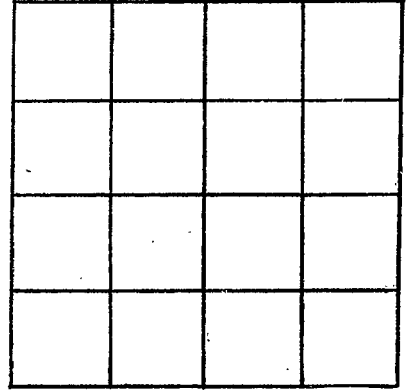

SECTION \_\_\_\_\_

Please indicate well location X.

ADDITIONAL INFORMATION

If more than one screen,  
show locations of each on sketch.