

**Marshall**  
**E 20**  
**4-23-70**

MISSISSIPPI  
 BOARD OF WATER COMMISSIONERS  
 416 North State Street  
 Jackson, Mississippi 39201

**CODED**

WATER WELL DRILLERS LOG

**MARSHALL**

4-23-1970 date well completed  
 Thorpe Well Supply Co. firm name  
 county well located

LANDOWNER: Pack Producers, Inc.  
1229 Kansas  
Memphis, Tennessee  
 (mailing address)

description of formations encountered	from	to
TOP SOIL	0	10
Red SAND	10	25
Red Sand & clay mix	25	35
Coarse sand	35	55
white clay & fine sand	55	65
white fine sand	65	95
" medium sand	95	115

WELL LOCATION: 156  
 sec. 30 T. 2 N. R. 4 E  
5 miles SW of Byhalia  
 (distance) (direction) (nearest town)

WELL PURPOSE: Ho 4 Park  
 (home, irrigation, municipal, Industrial)

- WELL COMPLETION DATA:
- (1) diameter (inches) 4"
  - (2) total depth (feet) 115"
  - (3) static water level (feet) 60 <sup>below</sup>/<sub>above</sub> top of ground.
  - (4) casing PVC (4"), 111',  
 (material) (depth)  
 (size) If telescope see back.
  - (5) screen 4", 111'  
 (length) (depth to top)  
4", PVC Filter Pack  
 (size) (material)
  - (6) pump 1  
 (HP) (yield gpm)  
220 SP  
 (type power)
  - (7) electric log NO  
 (yes or no)

**CODED**

JUN 1 - 1970


MISSISSIPPI  
 WATER

(organization running log)  
 (8) how well bottom plugged End  
of screen 4" cap

DRILLERS REMARKS:

If well telescopes please sketch and show depths.

GROUND LEVEL

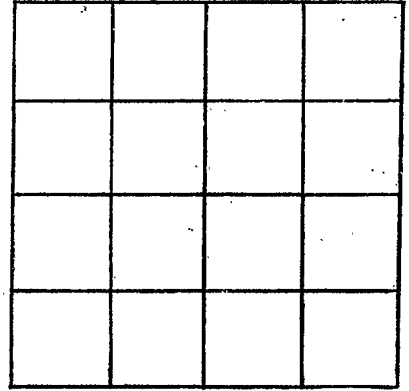

SECTION \_\_\_\_\_

Please indicate well location X.

ADDITIONAL INFORMATION

If more than one screen, show locations of each on sketch.