

MARSHALL  
E 23  
7-12-70

MISSISSIPPI  
BOARD OF WATER COMMISSIONERS  
416 North State Street  
Jackson, Mississippi 39201

**CODED**

WATER WELL DRILLERS LOG

July 12 1970 Earl Jones Well Co Marshall  
date well completed firm name county well located

LANDOWNER:  
Alvis H. Harris Jr.  
Collierville Tenn RT. 2.  
(mailing address)

description of formations encountered	from	to
	Top soil & clay sand	0
clay	20	50
sand	50	58
	58	88

WELL LOCATION:  
sec 2 T 2 N R 4 E  
 $\frac{1}{2}$  miles South of Cayce  
(distance) (direction) (nearest town)

WELL PURPOSE: Home  
(home, irrigation, municipal, industrial)

WELL COMPLETION DATA:

(1) diameter (inches) 2"  
 (2) total depth (feet) 88  
 (3) static water level (feet) 55 below top of ground.  
 (4) casing Steel, 84 FT.  
(material) (depth)  
(size) if telescope see back.  
 (5) screen 4 FT, 84  
(length) (depth to top)  
 2" Stainless Steel  
(size) (material)  
 (6) pump 3/4 HP, 3 1/2  
(HP) (yield gpm)  
 Electric  
(type power)  
 (7) electric log No.  
(yes or no)  
 (organization running log)  
 (8) how well bottom plugged  
 Steel Plug

**CODED**


AUG 11 1970

MISS. BD. OF  
WATER COMMISSIONERS

DRILLERS REMARKS:

If well telescopes please sketch and show depths.

GROUND LEVEL

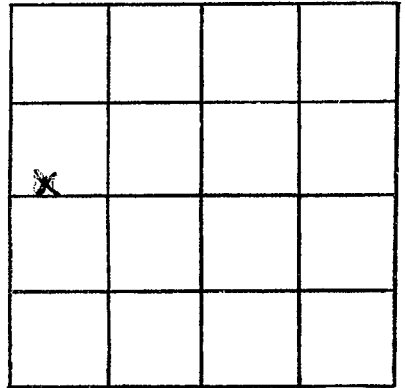

SECTION 3

Please indicate well location X.

ADDITIONAL INFORMATION

If more than one screen, show locations of each on sketch.