

MISSISSIPPI  
BOARD OF WATER COMMISSIONERS  
416 North State Street  
Jackson, Mississippi 39201

**CODED**

WATER WELL DRILLERS LOG

**MARSHALL**  
**E 25**  
**1-28-71**

Jan 28 19 71 Earl Jones Well Co. Marshall  
date well completed firm name county well located

LANDOWNER:	description of formations encountered	from	to
<u>John Mc Dermott</u>			
<u>Holly Springs Miss.</u> (mailing address)	<u>Top soil &amp; clay</u>	<u>0</u>	<u>20</u>
	<u>sand</u>	<u>20</u>	<u>25</u>
	<u>sand &amp; clay</u>	<u>25</u>	<u>40</u>
	<u>sand</u>	<u>40</u>	<u>110</u>
	<u>clay</u>	<u>110</u>	<u>120</u>
	<u>sand</u>	<u>120</u>	<u>136</u>
WELL LOCATION: sec. <u>2</u> T. <u>2</u> N. R. <u>4</u> E. <u>1 1/4</u> miles <u>SE.</u> of <u>Loyce</u> (distance) (direction) (nearest town)			
WELL PURPOSE: <u>Home</u> (home, irrigation, municipal, industrial)			
WELL COMPLETION DATA: (1) diameter (inches) <u>2"</u> (2) total depth (feet) <u>136</u> (3) static water level (feet) <u>85'</u> below above top of ground. (4) casing <u>plastic</u> <u>130'</u> (material) (depth) <u>2"</u> (size) if telescope see back. (5) screen <u>6"</u> <u>130'</u> (length) (depth to top) <u>2"</u> (size) <u>plastic filter pack</u> (material) (6) pump <u>1</u> <u>6</u> (HP) (yield gpm) <u>Electric</u> (type power) (7) electric log <u>No.</u> (yes or no) (organization running log) (8) how well bottom plugged <u>plastic cap.</u>			
DRILLERS REMARKS:			


**CODED**

MAR 1 - 1971

MISS. Bd. OF WATER COMM.

If well telescopes please sketch and show depths.

GROUND LEVEL

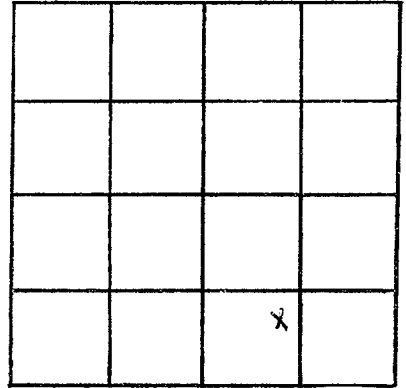

SECTION 2

Please indicate well location X.

ADDITIONAL INFORMATION

If more than one screen,  
show locations of each on sketch.