

MARSHALL
E 26
23-71

MISSISSIPPI
BOARD OF WATER COMMISSIONERS
416 North State Street
Jackson, Mississippi 39201

CODED

WATER WELL DRILLERS LOG

Atkinson & Frost MARSHALL

date well completed 19 firm name county well located

LANDOWNER: Ardella
Hardaway
Victoria Mies
(mailing address)

description of formations encountered	from	to
Red clay	0	15
1" sand	15	80
White sand	80	160

WELL LOCATION:

sec. 3 T 2 N R 4 E
6 miles NW of Victoria

WELL PURPOSE:
(home, irrigation, municipal, industrial)

WELL COMPLETION DATA:

- (1) diameter (inches) 4"
- (2) total depth (feet) 160 ft
- (3) static water level (feet) 115' below top of ground.
- (4) casing P.V.C. (material) (depth)
- 4" (size) If telescope see back.
- (5) screen 10' (length) 165' (depth to top)
- 4" (size) P.V.C. (material)
- (6) pump 3/4 (HP) 10 (yield gpm)
- Elec. (type power)
- (7) electric log NO (yes or no)

(organization running log)

(8) how well bottom plugged @ 14 ft

CODED


APR - 5 1971

MISS. BD. OF
WATER COMMISSIONERS

DRILLERS REMARKS:

If well telescopes please sketch and show depths.

GROUND LEVEL

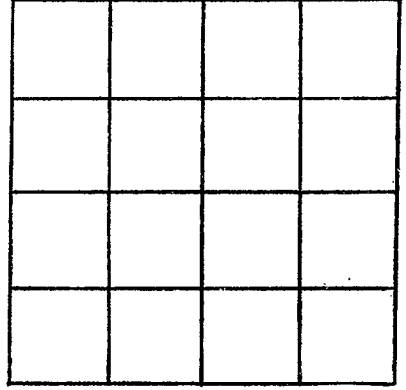

SECTION _____

Please indicate well location X.

ADDITIONAL INFORMATION

If more than one screen, show locations of each on sketch.