

MARSHALL
E 27
4-19-71

MISSISSIPPI
 BOARD OF WATER COMMISSIONERS
 416 North State Street
 Jackson, Mississippi 39201

CODED

WATER WELL DRILLERS LOG

April 14 1971 Earl Jones Well Co. Marshall
 date well completed firm name county well located

LANDOWNER:

description of formations encountered from to

Terry Sanderson
Victoria Miss
 (mailing address)

<u>Topsoil + clay</u>	<u>0</u>	<u>18</u>
<u>sand</u>	<u>18</u>	<u>28</u>
<u>clay</u>	<u>28</u>	<u>40</u>
<u>rock</u>	<u>40</u>	<u>41</u>
<u>sand</u>	<u>41</u>	<u>100</u>
<u>clay</u>	<u>110</u>	<u>120</u>
<u>sand</u>	<u>120</u>	<u>170</u>

WELL LOCATION:
 sec B4 T 2 N R 4 E
1 miles N of Victoria
 (distance) (direction) (nearest town)

WELL PURPOSE: Home
 (home, irrigation, municipal, industrial)

WELL COMPLETION DATA:

- (1) diameter (inches) 4"
- (2) total depth (feet) 170'
- (3) static water level (feet) 85 below above top of ground.
- (4) casing plastic 165'
 (material) (depth)
4" If telescope see back.
 (size)
- (5) screen 5' 165'
 (length) (depth to top)
4" plastic gravel
 (size) (material)
- (6) pump 1/2 10
 (HP) (yield gpm)
Electric
 (type power)
- (7) electric log no
 (yes or no)
 (organization running log)
- (8) how well bottom plugged -
plastic cap

CODED


APR 19 1971

MISS. SD. OF
 WATER COMM.

DRILLERS REMARKS:

If well telescopes please sketch and show depths.

GROUND LEVEL

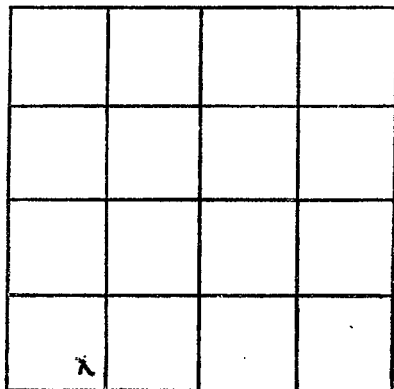

SECTION _____

Please indicate well location X.

ADDITIONAL INFORMATION

If more than one screen,
show locations of each on sketch.