

MARSHALL
E28
3-23-71

MISSISSIPPI
 BOARD OF WATER COMMISSIONERS
 416 North State Street
 Jackson, Mississippi 39201

CODED

WATER WELL DRILLERS LOG

Month March 23 19 71 Earl Jones Well Co Marshall
 date well completed firm name county well located

LANDOWNER:

Dave Smith

description of formations encountered

from to

Red Banks Miss. Pt 1
 (mailing address)

<u>Topsoil & clay</u>	<u>0</u>	<u>20</u>
<u>sand</u>	<u>0</u>	<u>45</u>
<u>clay</u>	<u>45</u>	<u>65</u>
<u>sand</u>	<u>65</u>	<u>126</u>

WELL LOCATION:

sec 35 T 2 N R 4 E
3 1/2 miles N.E. of Victoria
 (distance) (direction) (nearest town)

WELL PURPOSE: Home
 (home, irrigation, municipal, industrial)

WELL COMPLETION DATA:

- (1) diameter (inches) 4"
- (2) total depth (feet) 126'
- (3) static water level (feet) 70' below above top of ground.
- (4) casing plastic 121'
 (material) (depth)
- 4' if telescope see back.
 (size)
- (5) screen 5' 121'
 (length) (depth to top)
- 4" plastic filter pack
 (size) (material)
- (6) pump 1/2 (HP) (yield gpm)
Electric
 (type power)
- (7) electric log no
 (yes or no)

CODED

APR 19 1971

(organization running log)


(8) how well bottom plugged
plastic cap

MISS. BD. OF
 WATER COMM.

DRILLERS REMARKS:

If well telescopes please sketch and show depths.

GROUND LEVEL

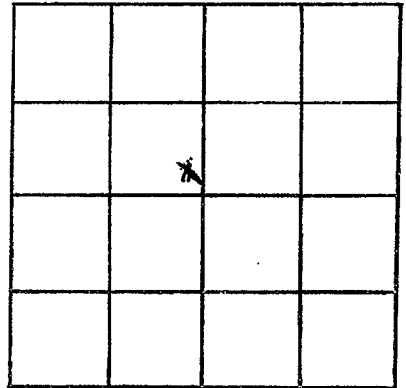

SECTION _____

Please indicate well location X.

ADDITIONAL INFORMATION

If more than one screen,
show locations of each on sketch.