

MARSHALL
E 31
3-25-71

MISSISSIPPI
 BOARD OF WATER COMMISSIONERS
 416 North State Street
 Jackson, Mississippi 39201

CODED

WATER WELL DRILLERS LOG

March 25 19 *71* *R. L. Carpenter* *Marshall*
 date well completed firm name county well located

LANDOWNER: *Dudley Harris*
Coyce, RFD
Miss.
 (mailing address)

WELL LOCATION:
 sec. 3 T. 2 N. R. 4 E.
1 1/4 miles *South* of *Coyce*
 (distance) (direction) (nearest town)

WELL PURPOSE: *None*
 (home, irrigation, municipal, industrial)

WELL COMPLETION DATA:

- (1) diameter (inches) 4 in.
- (2) total depth (feet) 100
- (3) static water level (feet) 22 below above top of ground.
- (4) casing Plastic, 9 ft.
 (material) (depth)
 (size) if telescope see back.
- (5) screen 6 ft., 9 ft.
 (length) (depth to top)
4 in. Plastic & Sand
 (size) (material)
- (6) pump 3/4 10
 (HP) (yield gpm)
Elec.
 (type power)
- (7) electric log No
 (yes or no)

(organization running log)

(8) how well bottom plugged Plastic Plug

description of formations encountered	from	to
<i>Surface Soil</i>	<i>0</i>	<i>12</i>
<i>Fine Red Sand</i>	<i>12</i>	<i>28</i>
<i>white Fine Sand</i>	<i>28</i>	<i>53</i>
<i>white Clay</i>	<i>53</i>	<i>61</i>
<i>med. white sand</i>	<i>61</i>	<i>80</i>
<i>med. coarse white Sand</i>	<i>80</i>	<i>100</i>

CODED


MAY 3 - 1971

MISS. BD. OF
 WATER COMM.

DRILLERS REMARKS:

If well telescopes please sketch and show depths.

GROUND LEVEL

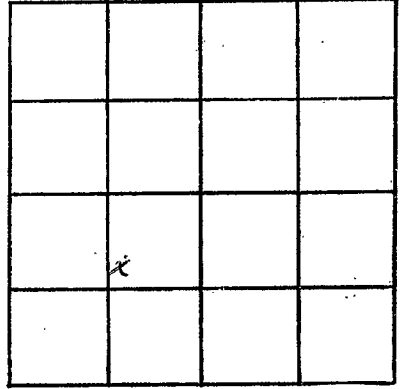

SECTION 3

Please indicate well location X.

ADDITIONAL INFORMATION

If more than one screen,
show locations of each on sketch.