

WATER WELL DRILLERS LOG

CODED

Date: 3-20, 1962, Driller: Adams Bros. Co. Inc. County Marshall

(Name)

(1) Owner of Land: Calvin Battle

(Name)

Bighalia Rte. 1

(Address)

30 24(2) Location: 1/4, 1/4, Sec. 30 24 T. 2 R. 41 miles 1/4 of 1/4

(distance)

(direction)

(Nearest Town)

(3) Topography:

(Hilly)

(Flat)

(Level)

(4) Purpose of Well:

(Domestic Irrigation
Municipal, Industrial, Other)


Information upon completion of well:

(1) Diameter 4 inches.(2) Total Depth 120 feet.(3) Water Level 83 feet below top of ground.(4) Cased to 106, Size 106(5) Screen: Size 4" Length 14'

(6) Were any formations sealed against pollution?

yes, no.If YES depth of formation 106Why 106Drillers Remarks: 106Description & Color of Materials
Sand, Clay, Red Clay, Shell, etc.Thick-
ness
FeetDepth
FeetTop soil0-10rock10-12red sand12-50medium whiter sand50-9.5coarse white sand9.5-120

CODED

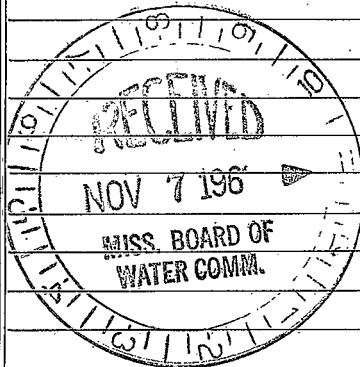

(Use Back Side)

Well No.

Mail this copy to Board of Water Commissioners 429 Miss. St. Jackson, N

Miss