

MARSHALL
E34

WATER WELL DRILLERS LOG

CODED

abc of Independence

Date: 11-29, 1963, Driller: ~~Adams Bros~~ County Marshall

(Name)

(1) Owner of Land: Levert malone
(Name)

Rte. 3 Box 102 Byhalia
(Address)

(2) Location: 1/4, 22, Sec. 24

 miles of
(distance) (direction) (Nearest Town)

(3) Topography:
(Hilly) (Flat) (Level)

(4) Purpose of Well:
(Domestic Irrigation
Municipal, Industrial, Other)

| Description & Color of Materials Sand, Clay, Red Clay, Shell, etc. | Thick- ness Feet | Depth Feet |
|---|------------------------|---------------|
| <u>top soil</u> | <u>0</u> | <u>15</u> |
| <u>gold sand</u> | <u>15</u> | <u>40</u> |
| <u>fine white sand</u> | <u>40</u> | <u>60</u> |
| <u>coarse sand</u> | <u>60</u> | <u>80</u> |

CODED

Information upon completion of well:

(1) Diameter 4 inches.

(2) Total Depth 80 feet.

(3) Water Level 40 feet below top of ground.

(4) Cased to 73, Size

(5) Screen: Size 4, Length 7


(6) Were any formations sealed against pollution?

 yes, no.

If YES depth of formation

Why

Drillers Remarks:

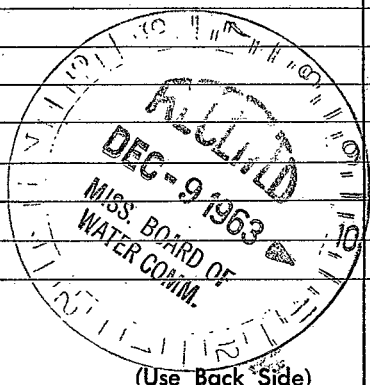

(Use Back Side)

Well No.

