

MARSHALL
E-35
4-26-71

MISSISSIPPI
 BOARD OF WATER COMMISSIONERS
 416 North State Street
 Jackson, Mississippi 39201

CODED

WATER WELL DRILLERS LOG

April 26 1971 R.L. Carpenter Marshall
 date well completed firm name county well located

LANDOWNER: Edward Dean Hanson
Cayce Truss
R. F. D.
 (mailing address)

description of formations encountered	from	to
Surface Soil	0	15
Med Red. Sand	15	34
White Fine Sand	34	60
Med white sand	60	75
White clay	75	82
White coarse sand	82	117

WELL LOCATION:
 sec 10 T 2 N. R. 4 E
2 miles southeast of Cayce
 (distance) (direction) (nearest town)

WELL PURPOSE: Home
 (home, irrigation, municipal, industrial)

WELL COMPLETION DATA:

- (1) diameter (inches) 4
- (2) total depth (feet) 117
- (3) static water level (feet) 79 below above top of ground.
- (4) casing Plastic, 117ft.
 (material) (depth)
- if telescope see back.
 (size)
- (5) screen 6ft., 117ft.
 (length) (depth to top)
- 1/2", Plastic Band
 (size) (material)
- (6) pump 1/2 8
 (HP) (yield gpm)
- Elec.
 (type power)
- (7) electric log No
 (yes or no)

CODED

SEP 2 1971

MISS. BD. OF
 WATER COMM.


(organization running log) Plastic Cap

(8) how well bottom plugged

DRILLERS REMARKS:

If well telescopes please sketch and show depths.

GROUND LEVEL

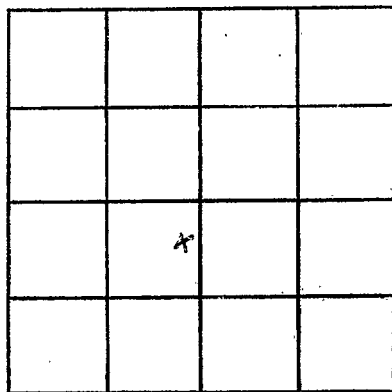

SECTION 10

Please indicate well location X.

ADDITIONAL INFORMATION

If more than one screen,
show locations of each on sketch.