

MARSHALL
 E 39
 10-66

MISSISSIPPI
 BOARD OF WATER COMMISSIONERS
 416 North State Street
 Jackson, Mississippi 39201

CODED

WATER WELL DRILLERS LOG

10-12 1966 Leak Well Co Marshall
 date well completed firm name county well located

LANDOWNER:
Hammond Realty Co
Rayne 25 Memphis Tenn
 (mailing address)

description of formations encountered	from	to
Surface clay	0	15
Fine sand & clay	15	65
Rock	65	66
White med-sand	66	110

WELL LOCATION:
 sec 3 T 2 N R 2 E
2 1/4 miles S.E. of Rayne
 (distance) (direction) (nearest town)

WELL PURPOSE: home
 (home, irrigation, municipal, industrial)

- WELL COMPLETION DATA:
- (1) diameter (inches) 4
 - (2) total depth (feet) 110
 - (3) static water level (feet) 62 below above top of ground.
 - (4) casing Plastic 104,
 (material) (depth)
 if telescope see back.
 (size)
 - (5) screen 4', 104
 (length) (depth to top)
4", Plastic
 (size) (material)
 - (6) pump 1/3 10
 (HP) (yield gpm)
Elec
 (type power)
 - (7) electric log
 (yes or no)

 (organization running log)
 - (8) how well bottom plugged Plastic


CODED

MAY 31 1966
 MISS. BOARD OF
 WATER COMMISSIONERS

DRILLERS REMARKS:
Owner furnished all
Material

If well telescopes please sketch and show depths.

GROUND LEVEL

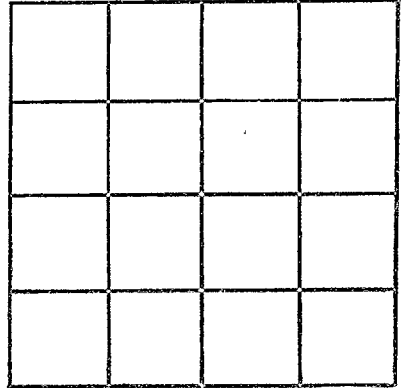

SECTION _____

Please indicate well location X.

ADDITIONAL INFORMATION

If more than one screen, show locations of each on sketch.