

MISSISSIPPI  
BOARD OF WATER COMMISSIONERS  
416 North State Street  
Jackson, Mississippi 39201

**CODED**

WATER WELL DRILLERS LOG

*Marshall*  
*E40*  
*5-67*

*May 4,* 19*67* *R. L. Carpenter* *Marshall*  
date well completed firm name county well located

LANDOWNER: *Newell Chapel Church*  
*Victoria,*  
*Miss.*  
(mailing address)

WELL LOCATION:  
sec. *27* T. ~~*27*~~ N R. *4* E  
S W  
*2* miles *north* of *Victoria*  
(distance) (direction) (nearest town)


WELL PURPOSE: *Church*  
(home, irrigation, municipal, industrial)

WELL COMPLETION DATA:

- (1) diameter (inches) *4 in*
- (2) total depth (feet) *127*
- (3) static water level (feet) *92* below  
top of ground. above
- (4) casing *Plastic, 121,*  
(material) (depth)  
*4 in* if telescope see back.  
(size)
- (5) screen *6 ft., 121*  
(length) (depth to top)  
*4 in, Plastic & Mesh*  
(size) (material)
- (6) pump *1/2* *11*  
(HP) (yield gpm)  
*Clear*  
(type power)
- (7) electric log *No.*  
(yes or no)  
*Plastic Plug*  
(organization running log)
- (8) how well bottom plugged *Plastic Plug*

Description of formations encountered	from	to
<i>Surface Soil</i>	<i>0</i>	<i>16</i>
<i>Coarse Red sand</i>	<i>16</i>	<i>47</i>
<i>Coarse White sand</i>	<i>47</i>	<i>80</i>
<i>Coarse Red sand</i>	<i>80</i>	<i>85</i>
<i>Coarse White sand</i>	<i>85</i>	<i>127</i>

**CODED**

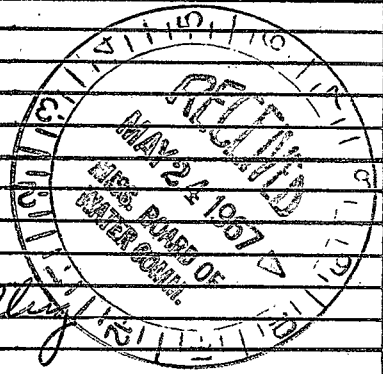


DRILLERS REMARKS:

If well telescopes please sketch and show depths.

GROUND LEVEL

R 4 W

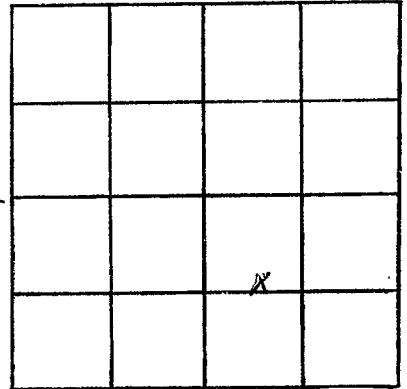

SECTION 27

Please indicate well location X.

ADDITIONAL INFORMATION

If more than one screen, show locations of each on sketch.