

Marshall  
E 41  
8-67

MISSISSIPPI  
BOARD OF WATER COMMISSIONERS  
416 North State Street  
Jackson, Mississippi 39201

**CODED**

WATER WELL DRILLERS LOG

Aug. 1 1967 R. L. Carpenter Marshall  
date well completed firm name county well located

LANDOWNER: John Carl  
Mt. Pleasant, Miss.  
R.F.D.  
(mailing address)

WELL LOCATION:  
sec. 5 T. 20 N R. 4 E  
S W  
2 miles west of Cayce  
(distance) (direction) (nearest town)


WELL PURPOSE: FARM  
(home, irrigation, municipal, industrial)

WELL COMPLETION DATA:

- (1) diameter (inches) 4 in.
- (2) total depth (feet) 134
- (3) static water level (feet) 30 below top of ground.
- (4) casing Plastic, 128 (material) (depth)
- (size) if telescope see back.
- (5) screen 6 ft., 128 ft. (length) (depth to top)  
4 in., Plastic & gravel (size) (material)
- (6) pump 1/2 12 (HP) (yield gpm)  
Eber (type power)
- (7) electric log no (yes or no)  
(organization running log)
- (8) how well bottom plugged Plaster Plug

description of formations encountered	from	to
Surface soil	0	16
med. Red sand	16	37
Coarse white sand	37	71
White clay	71	80
White clay and fine sand mixed	80	118
White coarse sand	118	134

**CODED**

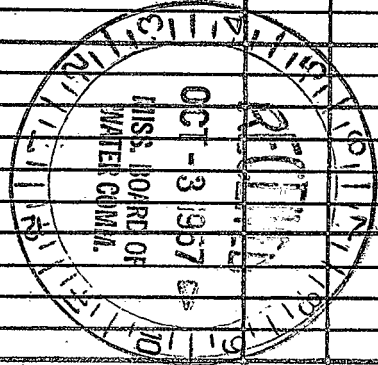

DRILLERS REMARKS:

If well telescopes please sketch and show depths.

GROUND LEVEL

R~~W~~W

725

			X

SECTION 5

Please indicate well location X.

ADDITIONAL INFORMATION

If more than one screen, show locations of each on sketch.