

Marshall  
E42  
5-9-68

MISSISSIPPI  
 BOARD OF WATER COMMISSIONERS  
 416 North State Street  
 Jackson, Mississippi 39201

**CODED**

WATER WELL DRILLERS LOG

May 9 1968 R. L. Carpenter Marshall  
 date well completed firm name county well located

LANDOWNER: Fred Moore

description of formations encountered

from to

Red Banks,  
Miss.  
 (mailing address)

Surface Soil 0 17

Med. Red Sand 17 40

WELL LOCATION:

sec. 36 T 2 N R 4 E  
 (S) (W)  
3 miles Northwest of Red Banks  
 (distance) (direction) (nearest town)

Med. & Coarse Red Sand 40 72

White Clay 72 184

WELL PURPOSE: Home  
 (home, irrigation, municipal, industrial)

White Coarse Sand 184 125

WELL COMPLETION DATA:

(1) diameter (inches) 4

(2) total depth (feet) 125

(3) static water level (feet) 63 below above top of ground.

(4) casing Plastic 119 ft.  
 (material) (depth)

\_\_\_\_\_ If telescope see back.  
 (size)

(5) screen 6 Ft. 119 ft.  
 (length) (depth to top)

**CODED**

4 in. Plastic & Sand  
 (size) (material)


(6) pump 3/4 12  
 (HP) (yield gpm)

Elec  
 (type power)

(7) electric log no  
 (yes or no)

\_\_\_\_\_ (organization running log)

(8) how well bottom plugged Plastic Plug

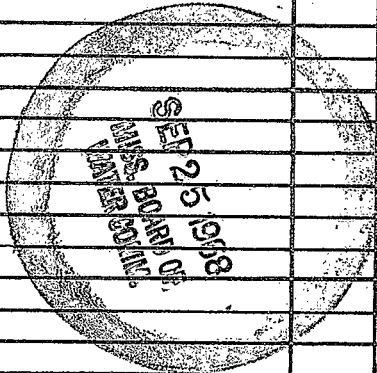

DRILLERS REMARKS:

If well telescopes please sketch and show depths.

GROUND LEVEL

*R4W*

*725*

			<i>*</i>

SECTION 36

Please indicate well location X.

ADDITIONAL INFORMATION

If more than one screen,  
show locations of each on sketch.