

Marshall  
 E43  
 5-14-68

MISSISSIPPI  
 BOARD OF WATER COMMISSIONERS  
 416 North State Street  
 Jackson, Mississippi 39201

**CODED**

WATER WELL DRILLERS LOG

May 14 1968 R. L. Carpenter Marshall  
 date well completed firm name county well located

LANDOWNER: Russell D. Houston  
 Holly Springs,  
 Miss.  
 (mailing address)

description of formations encountered	from	to
Surface Soil	0	18
Med. Red Sand	18	58
Med & Fine White sand	58	93
Med. White Sand	93	110
White Clay	110	115
White Fine Sand	115	124
White Coarse Sand	124	145

WELL LOCATION:  
 sec. 25 T 2 N R 4 E  
 S W  
 3 miles Northwest of Red Bank  
 (distance) (direction) (nearest town)

WELL PURPOSE: Farm  
 (home, irrigation, municipal, industrial)

WELL COMPLETION DATA:

(1) diameter (inches) 4

(2) total depth (feet) 145

(3) static water level (feet) 65 below top of ground.

(4) casing Plastic, 1.39,  
 (material) (depth)  
 (size) if telescope see back.


(5) screen 6 ft., 1.39 ft.  
 (length) (depth to top)  
 4 in. Plastic & Gravel  
 (size) (material)

(6) pump 3/4 12  
 (HP) (yield gpm)  
 Elec  
 (type power)

(7) electric log no  
 (yes or no)  
 (organization running log)

(8) how well bottom plugged Plastic Plug

**CODED**

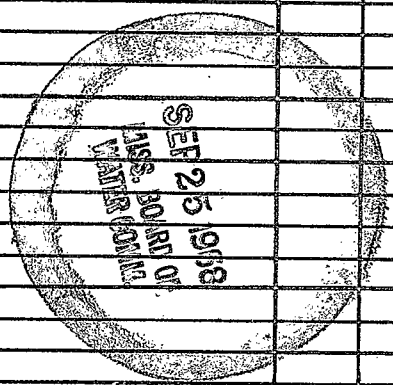


DRILLERS REMARKS:

If well telescopes please sketch and show depths.

GROUND LEVEL

R 4 W

+25

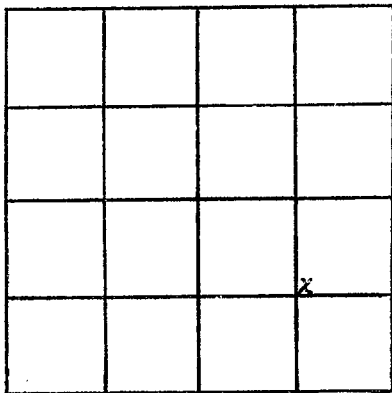

SECTION 25

Please indicate well location X.

ADDITIONAL INFORMATION

If more than one screen,  
show locations of each on sketch.