

Marshall  
#E45  
7-66

MISSISSIPPI BOARD OF WATER COMMISSIONERS

WATER WELL DRILLERS LOG

Marshall

Date: July, 1966, Driller: Harris Bras County: Franklin  
(When well drilled) (Name) (Where well is located)

(1) Owner of Land: Newton Sumner  
(Name)  
Pat. 1 Babilio  
(Address)  
(2) Location: NE 1/4, SE 1/4, Sec. 19 T5 R2  
2 miles NE, of Babilio  
(distance) (direction) (Nearest Town)  
(3) Topography: hilly  
(Hilly) (Flat) (Level)  
(4) Purpose of Well: domestic  
(Domestic Irrigation  
Municipal, Industrial, Other)


Description & Color of Materials Sand, Clay, Red Clay, Shell, etc.	Thick- ness Feet	Depth Feet
<u>top soil</u>	<u>0</u>	<u>20</u>
<u>red sand</u>	<u>20</u>	<u>40</u>
<u>W. clay and W. sand</u>	<u>40</u>	<u>90</u>
<u>Coarse W. sand</u>	<u>90</u>	<u>104</u>

Information upon completion of well:

(1) Diameter 4 inches.  
(2) Total Depth 104 feet.  
(3) Water Level 60 feet below top of ground.  
(4) Cased to 97, Size 4"  
(5) Screen: Size 4", Length 7'  
(6) Were any formations sealed against pollution?  
no

If YES depth of formation \_\_\_\_\_  
Why \_\_\_\_\_

Drillers Remarks: \_\_\_\_\_  
Yield in gpm: 7  
Size pump: 3/4 horse  
Type power: electric

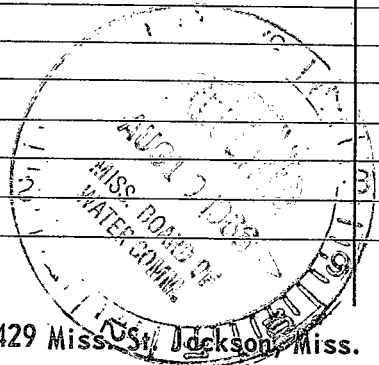

Mail this copy to Board of Water Commissioners 429 Miss. St. Jackson, Miss.

