

**MARSHALL**  
**E 46**  
**10-21-71**

MISSISSIPPI  
 BOARD OF WATER COMMISSIONERS  
 416 North State Street  
 Jackson, Mississippi 39201

**CODED**

WATER WELL DRILLERS LOG

Oct 21 1971 date well completed  
 Earl Jones Well Co. firm name  
 Marshall county well located

LANDOWNER:

Roy Keys  
 Collierville Tenn. RT 2  
 (mailing address)

description of formations encountered

from to

Topsoil & clay	0	14
sand	14	38
clay	38	60
sand	60	111

WELL LOCATION:

sec. 4 T 2 N R 4 E  
 1 miles South of Coyle  
 (distance) (direction) (nearest town)

WELL PURPOSE: Home  
 (home, irrigation, municipal, industrial)

WELL COMPLETION DATA:

- (1) diameter (inches) 2"
- (2) total depth (feet) 111
- (3) static water level (feet) \_\_\_\_\_ below/above top of ground.
- (4) casing galv. pipe 105 ft (material) (depth)  
 2" (size) if telescope see back.
- (5) screen 6 ft 105 ft (length) (depth to top)  
 2" plastic filter gauze (size) (material)
- (6) pump 1/2 HP 3 1/2 (yield gpm)  
 Electric (type power)
- (7) electric log No (yes or no)

**CODED**


(organization running log)

(8) how well bottom plugged plastic cap

DRILLERS REMARKS:

If well telescopes please sketch and show depths.

GROUND LEVEL

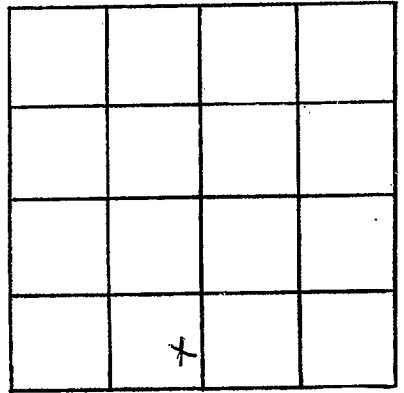

SECTION 4

Please indicate well location X.

ADDITIONAL INFORMATION

If more than one screen,  
show locations of each on sketch.