

MARSHALL
E 47
10-29-71

MISSISSIPPI
 BOARD OF WATER COMMISSIONERS
 416 North State Street
 Jackson, Mississippi 39201

WATER WELL DRILLERS LOG

date well completed 10-29-1971 firm name Robert W. W. CODE county Marshall well located

LANDOWNER: Leona and Vernon
Collinsville
Tenn.
 (mailing address)

WELL LOCATION:
 sec. 9 T. 2 N. R. 4 E.
 (distance) miles (direction) of (nearest town)

WELL PURPOSE:
 (home, irrigation, municipal, industrial)

- WELL COMPLETION DATA:
- (1) diameter (inches) 4
 - (2) total depth (feet) 103
 - (3) static water level (feet) 25 below above top of ground.
 - (4) casing Plexiglas, 104,
 (material) (depth)
4 if telescope see back.
 (size)
 - (5) screen 4, 104
 (length) (depth to top)
4, Hand Push
 (size) (material)
 - (6) pump 3/4, 10
 (HP) (yield gpm)
Electric
 (type power)
 - (7) electric log
 (yes or no)
- (organization running log)
- (8) how well bottom plugged 4/11
Plastic Cap

Description of formations encountered	from	to
<u>Red Clay Redbed</u>	<u>0</u>	<u>20</u>
<u>Red Sand</u>	<u>20</u>	<u>40</u>
<u>Red Sand White Clay</u>	<u>40</u>	<u>60</u>
<u>White Clay White Sand</u>	<u>60</u>	<u>80</u>
<u>White Sand</u>	<u>80</u>	<u>103</u>

CODED


FFR-8 1070

DRILLERS REMARKS:

DRILLER'S SIGNATURE
 WATER BOARD

If well telescopes please sketch and show depths.

GROUND LEVEL

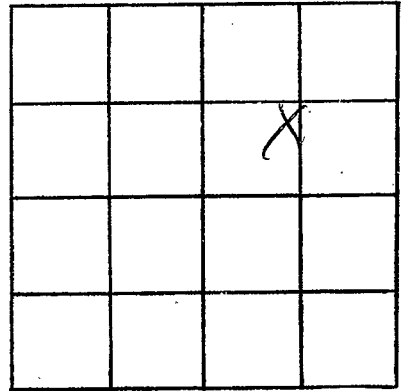

SECTION 9

Please indicate well location X.

ADDITIONAL INFORMATION

If more than one screen,
show locations of each on sketch.