

MARSHALL
E 49
2-22-72

MISSISSIPPI
 BOARD OF WATER COMMISSIONERS
 416 North State Street
 Jackson, Mississippi 39201

WATER WELL DRILLERS LOG

CODED

Feb 22 1972
 date well completed

Earl Jones Well Co
 firm name

Marshall
 county well located

LANDOWNER:

Leon Hall

Red Bank Miss RT 1
 (mailing address)

WELL LOCATION:

sec 36 T 2 N R 4 E
 3 3/4 miles N.W. of Red Bank
 (distance) (direction) (nearest town)

WELL PURPOSE: Home
 (home, irrigation, municipal, industrial)

WELL COMPLETION DATA:

- (1) diameter (inches) 2"
- (2) total depth (feet) 100
- (3) static water level (feet) 50 below above, top of ground.
- (4) casing plastic 94
 (material) (depth)
2 if telescope see back.
 (size)
- (5) screen 6' 94
 (length) (depth to top)
2" plastic filter pipe
 (size) (material)
- (6) pump 1 9
 (HP) (yield gpm)
Electric
 (type power)
- (7) electric log No
 (yes or no)

(organization running log)

(8) how well bottom plugged
plastic cap

description of formations encountered

from

clay & sand
 clay
 sand
 clay
 sand

0	15
15	20
20	40
40	44
44	100


CODED

DRILLERS REMARKS:

FEB 28 1972

If well telescopes please sketch and show depths.

GROUND LEVEL

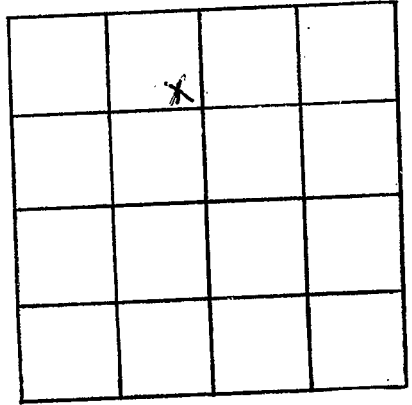

SECTION _____

Please indicate well location X.

ADDITIONAL INFORMATION

If more than one screen,
show locations of each on sketch.