

MARSHALL
E 50
7-72

MISSISSIPPI
 BOARD OF WATER COMMISSIONERS
 416 North State Street
 Jackson, Mississippi 39201

CODED

WATER WELL DRILLERS LOG

Attorney & Frost Marshall

date well completed 19 firm name _____ county well located _____

LANDOWNER:

Florence Coleman

description of formations encountered

from to

Vicksburg Miss
 (mailing address)

Clay 0 15
Coarse sand 15 80
White sand 80 130

WELL LOCATION:

sec. 3 T. 2 N. R. 4 E.
9 miles N of Vicksburg
 (distance) (direction) (nearest town)

WELL PURPOSE:

(home, irrigation, municipal, industrial)

WELL COMPLETION DATA:

- (1) diameter (inches) 4"
- (2) total depth (feet) 130
- (3) static water level (feet) 90 below above top of ground.
- (4) casing P.V.C. 130
 (material) (depth)
 (size) If telescope see back.
- (5) screen 10 ft 120
 (length) (depth to top)
4" P.V.C.
 (size) (material)
- (6) pump 3/4 10
 (HP) (yield gpm)
elec.
 (type power)
- (7) electric log _____
 (yes or no)
 (organization running log)
- (8) how well bottom plugged CAP.


CODED

III 12 1972

DRILLERS REMARKS:

If well telescopes please sketch and show depths.

GROUND LEVEL

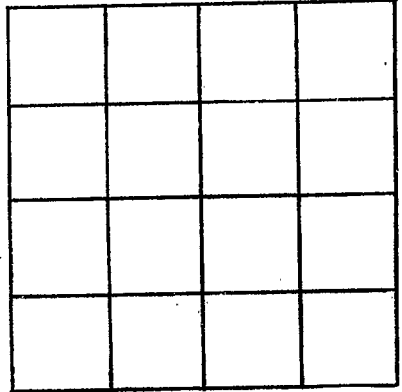

SECTION _____

Please indicate well location X.

ADDITIONAL INFORMATION

If more than one screen, show locations of each on sketch.