

MARSHALL
E 54
8-9-72

MISSISSIPPI
 BOARD OF WATER COMMISSIONERS
 416 North State Street
 Jackson, Mississippi 39201

CODED

WATER WELL DRILLERS LOG

Aug 9 1972 Evel Jones Well Co Marshall
 date well completed firm name county well located

LANDOWNER:
Boiley Brooks

WELL LOCATION:
 sec 32 T 2 N R 4 E
 S W
1/4 miles N of Victoria
 (distance) (direction) (nearest town)

| description of formations encountered | from | to |
|---------------------------------------|-----------|------------|
| <u>Topsoil</u> | <u>0</u> | <u>8</u> |
| <u>sand</u> | <u>8</u> | <u>20</u> |
| <u>clay</u> | <u>20</u> | <u>32</u> |
| <u>Rock</u> | <u>32</u> | <u>33</u> |
| <u>sand</u> | <u>33</u> | <u>59</u> |
| <u>clay</u> | <u>59</u> | <u>95</u> |
| <u>sand</u> | <u>95</u> | <u>166</u> |

WELL PURPOSE: Home
 (home, irrigation, municipal, industrial)

WELL COMPLETION DATA:

(1) diameter (inches) 4"

(2) total depth (feet) 166'

(3) static water level (feet) 92 below above top of ground.

(4) casing Plastic 160'
 (material) (depth)
4" if telescope see back.
 (size)

(5) screen 6' 160'
 (length) (depth to top)
4" plastic gravel
 (size) (material)

(6) pump 3/4 15
 (HP) (yield gpm)
Electric
 (type power)

(7) electric log no
 (yes or no)

(organization running log)

(8) how well bottom plugged plastic cap

CODED


AUG 10 1972

DRILLERS REMARKS:

MISS. BD. OF
 WATER COM.

If well telescopes please sketch and show depths.

GROUND LEVEL

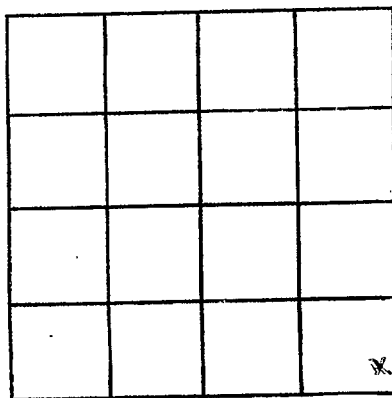

SECTION 33

Please indicate well location X.

ADDITIONAL INFORMATION

If more than one screen,
show locations of each on sketch.