

MARSHALL
E 55
8-4-72

MISSISSIPPI
 BOARD OF WATER COMMISSIONERS
 416 North State Street
 Jackson, Mississippi 39201

CODED

WATER WELL DRILLERS LOG

aug 4 1972 Earl Jones Well Co Marshall
 date well completed firm name county well located

LANDOWNER:
Woodrow Beeman
Byhalia miss RT.
 (mailing address)

description of formations encountered	from	to
<u>Topsoil - clay sand</u>	<u>0</u>	<u>8</u>
<u>Rock</u>	<u>8</u>	<u>14</u>
<u>clay sand</u>	<u>14</u>	<u>15</u>
	<u>15</u>	<u>130</u>
	<u>100</u>	<u>144</u>

WELL LOCATION:
 sec. 29 T. 2 N. R. 4 E.
2 1/2 miles of N Victoria
 (distance) (direction) (nearest town)

WELL PURPOSE: Home
 (home, irrigation, municipal, industrial)

- WELL COMPLETION DATA:
- diameter (inches) 2
 - total depth (feet) 144
 - static water level (feet) 90 below above top of ground.
 - casing plastic 138'
 (material) (depth)
2'
 (size) If telescope see back.
 - screen 6' 138'
 (length) (depth to top)
2' plastic gravel
 (size) (material)
 - pump 1 3
 (HP) (yield gpm)
Electric
 (type power)
 - electric log no.
 (yes or no)
- (organization running log)
- (8) how well bottom plugged plastic cap

CODED


AUG 19 1972
 AUG 29 1972

MISS. BD. OF
 WATER COM.

DRILLERS REMARKS:

If well telescopes please
 sketch and show depths.

GROUND LEVEL

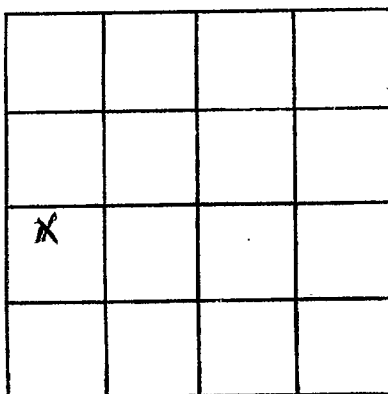

SECTION 29

Please indicate well location X.

ADDITIONAL INFORMATION

If more than one screen,
 show locations of each on sketch.