

MARSHALL
E56
8-28-72

MISSISSIPPI
 BOARD OF WATER COMMISSIONERS
 416 North State Street
 Jackson, Mississippi 39201

WATER WELL DRILLERS LOG

CODED

8-28 1972 Hicks Brothers MARSHAL
 date well completed firm name county well located

LANDOWNER: RAIPH AVENT
Realtor Co.
Holly Springs, Miss
 (mailing address)

description of formations encountered	from	to
<u>Red SAND</u>	<u>0</u>	<u>30</u>
<u>Red sandy CLAY</u>	<u>30</u>	<u>45</u>
<u>White SAND</u>	<u>45</u>	<u>205</u>

WELL LOCATION:
 sec. 27 T. 2 N. R. 4 E
3 miles North of Victory
 (distance) (direction) (nearest town)

WELL PURPOSE: Home
 (home, irrigation, municipal, industrial)

- WELL COMPLETION DATA:
- (1) diameter (inches) 1 1/2"
 - (2) total depth (feet) 205
 - (3) static water level (feet) 55 below above top of ground.
 - (4) casing PLASTIC, 187
 (material) (depth)
0 If telescope see back.
 (size)
 - (5) screen 18', 18'
 (length) (depth to top)
4", GRAVEL TPB
 (size) (material)
 - (6) pump 5, 80
 (HP) (yield gpm)
220 F1EC
 (type power)
 - (7) electric log (yes or no) _____
 (organization running log) _____
 - (8) how well bottom plugged CAP


CODED

SEP 18 1972
 MISS. STATE
 WATER BOARD

DRILLERS REMARKS:

If well telescopes please sketch and show depths.

GROUND LEVEL

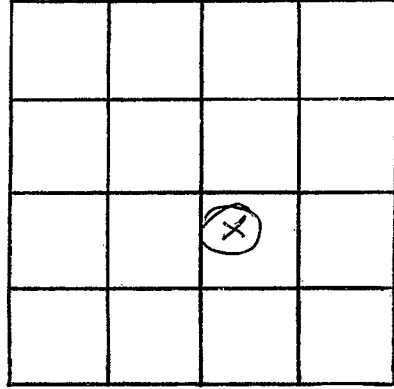

SECTION _____

Please indicate well location X.

ADDITIONAL INFORMATION

A series of horizontal lines for writing additional information.

If more than one screen, show locations of each on sketch.