

MARSHALL

E 60

10-26-72

MISSISSIPPI BOARD OF WATER COMMISSIONERS
416 North State Street
Jackson, Mississippi 39201

CODED

WATER WELL DRILLERS LOG

10-26-1972 date well completed Bob Smith firm name Marshall county well located

LANDOWNER:

Robert Howard

description of formations encountered

clay dirt

from

to

10

Cany, Miss.
(mailing address)

yellow clay

10

20

WELL LOCATION:

sec. 4 T. 2 N. R. 4 E. S. W.
3/4 miles South of Cayce
(distance) (direction) (nearest town)

red sand

20

67

blue clay

67

80

white sand

80

138

WELL PURPOSE:

None
(home, irrigation, municipal, industrial)

WELL COMPLETION DATA:

- (1) diameter (inches) 4
- (2) total depth (feet) 138
- (3) static water level (feet) 51 below above top of ground.
- (4) casing Plastic, 138' (material) (depth)
- (size) if telescope see back.
- (5) screen 20 (length), 118 (depth to top)
- 4 (size), Plastic (material)
- (6) pump 1/3 (HP), 10 (yield gpm)
- Elec (type power)
- (7) electric log no (yes or no)

CODED

(organization running log)

(8) how well bottom plugged


plugged

DRILLERS REMARKS:

FEB 22 1973

If well telescopes please sketch and show depths.

GROUND LEVEL

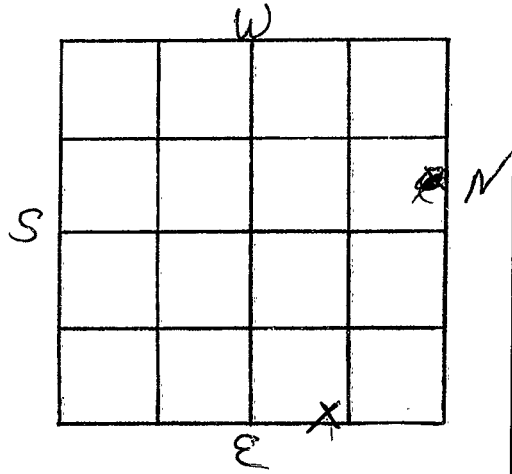

SECTION 4

Please indicate well location X.

ADDITIONAL INFORMATION

If more than one screen, show locations of each on sketch.