

**MARSHALL**  
**E 61**  
**3-12-73**

MISSISSIPPI  
 BOARD OF WATER COMMISSIONERS  
 416 North State Street  
 Jackson, Mississippi 39201

**CODED**

**WATER WELL DRILLERS LOG**

3-12 1973 Robert W. Watson Marshall  
 date well completed firm name county well located

LANDOWNER: Paul Keener  
Marshall, Miss  
 (mailing address)

description of formations encountered	from	to
<u>red clay, red sand</u>	<u>0</u>	<u>30</u>
<u>red sand white clay</u>	<u>30</u>	<u>60</u>
<u>white clay, white sand</u>	<u>60</u>	<u>90</u>
<u>white sand</u>	<u>90</u>	<u>108</u>

WELL LOCATION:  
 sec. 9 T 2 N. R. 4 E  
 (S) (W)  
 \_\_\_\_\_ miles \_\_\_\_\_ of \_\_\_\_\_  
 (distance) (direction) (nearest town)

WELL PURPOSE:  
 (home, irrigation, municipal, industrial)

WELL COMPLETION DATA:

(1) diameter (inches) 4

(2) total depth (feet) 106

(3) static water level (feet) 35 below  
 top of ground.

(4) casing \_\_\_\_\_, \_\_\_\_\_  
 (material) (depth)  
 \_\_\_\_\_ if telescope see back.  
 (size)

(5) screen 8 \_\_\_\_\_, \_\_\_\_\_  
 (length) (depth to top)  
4 \_\_\_\_\_, \_\_\_\_\_  
 (size) (material)

(6) pump 3/4 \_\_\_\_\_, \_\_\_\_\_  
 (HP) (yield gpm)  
electric  
 (type power)

(7) electric log \_\_\_\_\_  
 (yes or no)  
 \_\_\_\_\_  
 (organization running log)

(8) how well bottom plugged 4" plastic  
cap


**CODED**

DRILLERS REMARKS:

Mar 9 1973

If well telescopes please sketch and show depths.

GROUND LEVEL

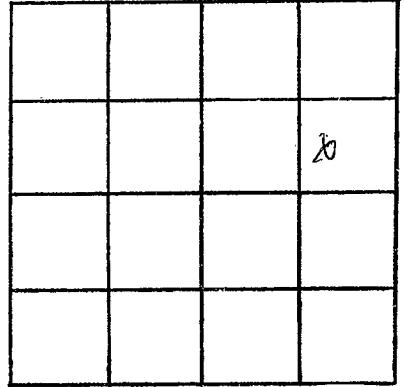

SECTION 9

Please indicate well location X.

ADDITIONAL INFORMATION

If more than one screen,  
show locations of each on sketch.