

**MARSHALL**  
**E 63.**  
**5-5-73**

MISSISSIPPI  
 BOARD OF WATER COMMISSIONERS  
 416 North State Street  
 Jackson, Mississippi 39201

**CODED**

**WATER WELL DRILLERS LOG**

May 5 1973 Earl Jona Well Co. Marshall  
 date well completed firm name county well located

LANDOWNER:  
J.P. Woods  
Byholia Miss.  
 (mailing address)

description of formations encountered	from	to
<u>Topsoil</u>	<u>0</u>	<u>10</u>
<u>sand</u>	<u>10</u>	<u>85</u>
	<del>85</del>	<del>105</del>
<u>clay</u>	<u>85</u>	<u>89</u>
<u>sand</u>	<u>89</u>	<u>154</u>

WELL LOCATION:  
 sec. 31 T. 2 S. R. 4  
1/2 miles N.E. of Byholia  
 (distance) (direction) (nearest town)

WELL PURPOSE: Private ground  
 (home, irrigation, municipal, industrial)

WELL COMPLETION DATA:

(1) diameter (inches) 4"

(2) total depth (feet) 154

(3) static water level (feet) 82' below above top of ground.

(4) casing Plastic 148'  
 (material) (depth)  
4" if telescope see back.  
 (size)

(5) screen 6" 148  
 (length) (depth to top)  
4" plastic gravel  
 (size) (material)

(6) pump 3/4 28  
 (HP) (yield gpm)  
Electric  
 (type power)

(7) electric log no  
 (yes or no)

(organization running log)

(8) how well bottom plugged plastic cap


**CODED**

MAY 9 1973

DRILLERS REMARKS:

If well telescopes please sketch and show depths.

GROUND LEVEL

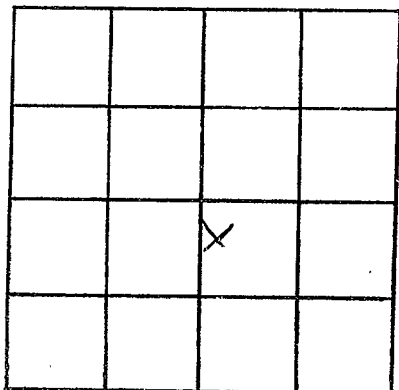

SECTION 31

Please indicate well location X.

ADDITIONAL INFORMATION

If more than one screen,  
show locations of each on sketch.