

MARSHALL  
E 64  
5-1-73

MISSISSIPPI  
BOARD OF WATER COMMISSIONERS  
416 North State Street  
Jackson, Mississippi 39201

**CODED**

WATER WELL DRILLERS LOG

5-1-1973 date well completed  
Dean & Kent Burpee well firm name  
Marshall county well located

LANDOWNER:

Russell G. Anderson Jr.  
Victoria, Miss.  
(mailing address)

description of formations encountered

from	to
0	20
20	60
60	90
90	130

clay  
sand  
clay  
sand

WELL LOCATION:

sec. 10 T. 2 N. R. 4 E.  
5 miles North of Victoria  
(distance) (direction) (nearest town)

WELL PURPOSE: Dwelling  
(home, irrigation, municipal, industrial)

WELL COMPLETION DATA:

- (1) diameter (inches) 4"
- (2) total depth (feet) 130 feet
- (3) static water level (feet) 45 below above top of ground.
- (4) casing PVC 130 feet  
(material) (depth)  
(size) if telescope see back.
- (5) screen 7 ft. 123 feet  
(length) (depth to top)  
4" gravel wall  
(size) (material)
- (6) pump 3/4 14  
(HP) (yield/gpm)  
(type power)
- (7) electric log Elect.  
(yes or no)  
(organization running log)
- (8) how well bottom plugged 4" Cap.

**CODED**


JUN 8 1973

DRILLERS REMARKS:

MISS. BD. OF  
WATER COMM.

If well telescopes please sketch and show depths.

GROUND LEVEL

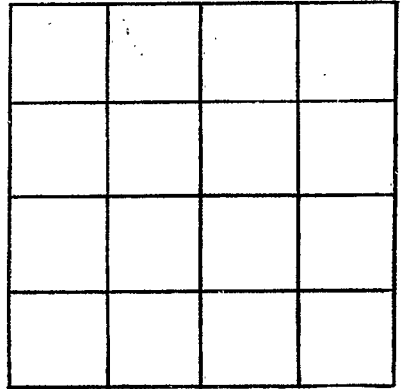

SECTION \_\_\_\_\_

Please indicate well location X.

ADDITIONAL INFORMATION

If more than one screen, show locations of each on sketch.