

E 67
MARSHALL
B-20-13

MISSISSIPPI
BOARD OF WATER COMMISSIONERS
416 North State Street
Jackson, Mississippi 39201

CODED

WATER WELL DRILLERS LOG

July 28 1973 R. L. Carpenter Marshall
date well completed firm name county well located

LANDOWNER: Jerry Clump
Victoria, Miss.
RFD
(mailing address)

description of formations encountered	from	to
surface soil	0	12
med. Red sand	12	40
white clay & white fine sand	40	60
white coarse sand	60	82

WELL LOCATION:
sec. 16 T. 2 N. R. 4 E
3 miles South of Cozer
(distance) (direction) (nearest town)

WELL PURPOSE: none
(home, irrigation, municipal, industrial)

- WELL COMPLETION DATA:
- (1) diameter (inches) 4
 - (2) total depth (feet) 82
 - (3) static water level (feet) 32 below top of ground
 - (4) casing Plastic, 76 ft.
(material) (depth)
_____ if telescope see back.
(size)
 - (5) screen 6 ft., 76 ft.
(length) (depth to top)
4 in. - Plastic thread
(size) (material)
 - (6) pump 1/3 8
(HP) (yield gpm)
E-bee
(type power)
 - (7) electric log no
(yes or no)


(organization running log)
 - (8) how well bottom plugged Plastic cap

DRILLERS REMARKS:

AUG 17 1973

If well telescopes please sketch and show depths.

GROUND LEVEL

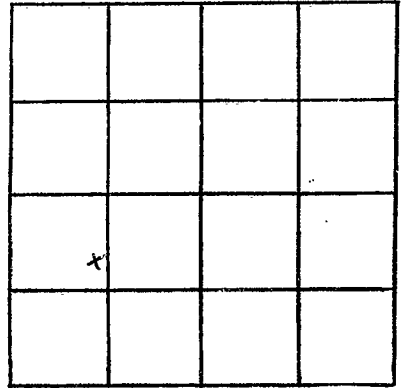

SECTION 13

Please indicate well location X.

ADDITIONAL INFORMATION

If more than one screen,
show locations of each on sketch.