

MARSHALL

E 68

8-19-73

MISSISSIPPI BOARD OF WATER COMMISSIONERS  
416 North State Street  
Jackson, Mississippi 39201

CODED

WATER WELL DRILLERS LOG

~~Sept~~ Aug. 19 1973 Earl Jones Well Co. - Marshall  
date well completed firm name county well located

LANDOWNER: Mose Scott  
Collierville Tenn. P.O.

description of formations encountered

from

to

Topsoil + clay  
sand  
clay  
sand

0 18  
18 78  
78 81  
81 142

(mailing address)

WELL LOCATION:

sec. 10 T. 2 N R. 4 E  
1 1/2 miles SE of Coyle.  
(distance) (direction) (nearest town)

CODED

WELL PURPOSE: Home  
(home, irrigation, municipal, industrial)

WELL COMPLETION DATA:

- (1) diameter (inches) 2"
- (2) total depth (feet) 142
- (3) static water level (feet) 82 below top of ground.
- (4) casing plastic 134' (material) (depth)  
2" (size) if telescope see back.
- (5) screen 8' 134' (length) (depth to top)  
2" plastic gravel (size) (material)
- (6) pump 1 (HP) 6 (yield gpm)  
Electric (type power)
- (7) electric log No - (yes or no)

(organization running log)

(8) how well bottom plugged  
plastic cap.


DRILLERS REMARKS:

SEP 20 1973

MISS. Bd OF WATER COMM.

If well telescopes please sketch and show depths.

GROUND LEVEL

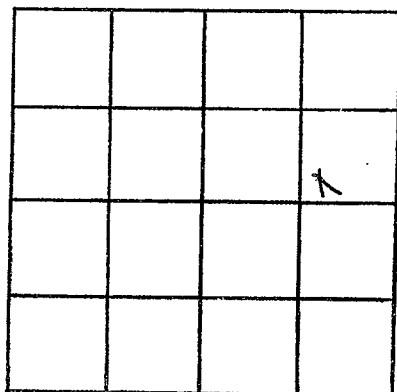

SECTION 3

Please indicate well location X.

ADDITIONAL INFORMATION

If more than one screen,  
show locations of each on sketch.