

MARSHALL  
E 69  
9-11-73

MISSISSIPPI  
BOARD OF WATER COMMISSIONERS  
416 North State Street  
Jackson, Mississippi 39201

**CODED**

WATER WELL DRILLERS LOG

Sept. 11 19 73 Earl Jones Well Co Marshall  
date well completed firm name county well located

LANDOWNER: Joe Tenniel  
Byholia Miss. RT 1  
(mailing address)

WELL LOCATION:  
sec. 12 T. 2 N R. 4 E  
3 miles NE of Byholia  
(distance) (direction) (nearest town)

WELL PURPOSE: Home  
(home, irrigation, municipal, industrial)

- WELL COMPLETION DATA:
- (1) diameter (inches) 4"
  - (2) total depth (feet) 164
  - (3) static water level (feet) 85 below top of ground.
  - (4) casing plastic, 158' (material) (depth)  
4" (size) if telescope see back.
  - (5) screen 6' 158' (length) (depth to top)  
4" plastic gravel (size) (material)
  - (6) pump 1/2 15 (HP) (yield gpm)  
Electric (type power)
  - (7) electric log no (yes or no)
  - (organization running log)
  - (8) how well bottom plugged plastic cap

description of formations encountered	from	to
Topsoil + clay	0	18
sand	18	65
clay	65	75
sand	75	82
clay	82	90
sand	90	105
clay	105	118
sand	118	164

**CODED**


SEP 20 1973

DRILLERS REMARKS:

MISS. BD. OF  
WATER COMMISSIONERS

If well telescopes please sketch and show depths.

GROUND LEVEL

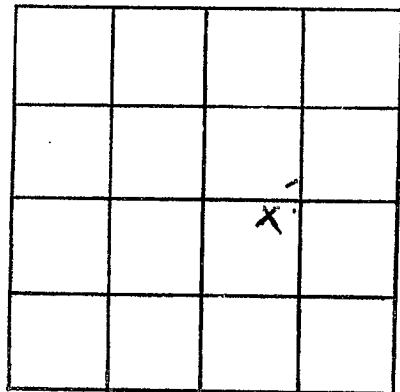

SECTION 12

Please indicate well location X.

ADDITIONAL INFORMATION

If more than one screen, show locations of each on sketch.