

MARSHALL
E 71
4-16-73

MISSISSIPPI
BOARD OF WATER COMMISSIONERS
416 North State Street
Jackson, Mississippi 39201

CODED

WATER WELL DRILLERS LOG

4-16-1973 date well completed Bob Smith firm name Marshall county well located

LANDOWNER:
Charles Watkins
Caucy - Miss (mailing address)

description of formations encountered	from	to
Clay first	10	19
white clay	19	30
Red sand	30	40
yellow sand	40	50
white sand	50	110

WELL LOCATION:
sec 9 T 2 N R 4 E S W
2 miles South of Caucy (distance) (direction) (nearest town)

WELL PURPOSE: None (home, irrigation, municipal, industrial)

- WELL COMPLETION DATA:
- (1) diameter (inches) 4
 - (2) total depth (feet) 110
 - (3) static water level (feet) 42 below top of ground
 - (4) casing Plastic 110 (material) (depth)
 - _____ If telescope see back. (size)
 - (5) screen 20 90 (length) (depth to top)
 - 4 Plastic (size) (material)
 - (6) pump 1/3 10 (HP) (yield gpm)
 - Elec (type power)
 - (7) electric log no (yes or no)
 - _____ (organization running log)

CODED

(8) how well bottom plugged plugged


DRILLERS REMARKS:

SEP 27 1973

MISSISSIPPI BOARD OF WATER COMMISSIONERS

If well telescopes please sketch and show depths.

GROUND LEVEL

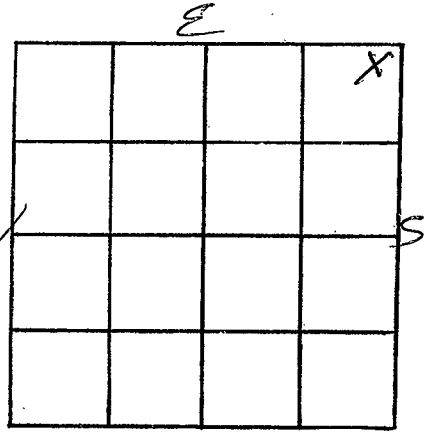

SECTION 9

Please indicate well location X.

ADDITIONAL INFORMATION

If more than one screen,
show locations of each on sketch.