

MARSHALL

E 72

9-6-73

MISSISSIPPI BOARD OF WATER COMMISSIONERS  
416 North State Street  
Jackson, Mississippi 39201

CODED

WATER WELL DRILLERS LOG

9-6  
date well completed

1973 Deontket Builders  
firm name

Marshall  
county well located

LANDOWNER:

Scotty Messersmith

Bethel, Miss.  
(mailing address)

description of formations encountered

clay

sand

clay

sand

from

to

0 20

20 90

90 95

95 150

WELL LOCATION:

sec. 20 2 N R 4 E  
5 miles North of Bethel  
(distance) (direction) (nearest town)

WELL PURPOSE: Domestic  
(home, irrigation, municipal, industrial)

WELL COMPLETION DATA:


- (1) diameter (inches) 4"
- (2) total depth (feet) 150 feet
- (3) static water level (feet) 20 feet below top of ground.
- (4) casing PVC, 150 feet (material) (depth)
- (size) If telescope see back.
- (5) screen 7 ft. 14 3 feet (length) (depth to top)
- 4" gravel wall (size) (material)
- (6) pump 3/4 HP 14 (yield) (HP) (gpm)
- (type power)
- (7) electric log elect. (yes or no)
- (organization running log)
- (8) how well bottom plugged 4"

DRILLERS REMARKS:

OCT 9 1973

If well telescopes please sketch and show depths.

GROUND LEVEL

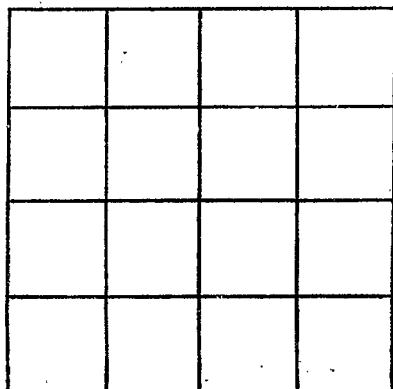

SECTION \_\_\_\_\_

Please indicate well location X.

ADDITIONAL INFORMATION

If more than one screen,  
show locations of each on sketch.