

Spelling

MARSHALL
E 73
11-9-73

MISSISSIPPI
BOARD OF WATER COMMISSIONERS
416 North State Street
Jackson, Mississippi 39201

WATER WELL DRILLERS LOG

11-9 1973 Dean Hest Bumpwell Marshall
date well completed firm name county well located

| LANDOWNER: | description of formations encountered | from | to |
|--|---------------------------------------|-----------|------------|
| | | | |
| <u>Arnold R. Hyatt</u> | <u>Clay</u> | <u>0</u> | <u>20</u> |
| <u>Rt. 1, Bynah, Miss</u> (mailing address) | <u>Sand</u> | <u>20</u> | <u>150</u> |

WELL LOCATION:
sec. 34 T 2 N R. 4 E
3 miles North of Victoria
(distance) (direction) (nearest town)

WELL PURPOSE: Dwelling
(home, irrigation, municipal, industrial)

- WELL COMPLETION DATA:
- (1) diameter (inches) 11"
 - (2) total depth (feet) 150 feet
 - (3) static water level (feet) 110 ^{below} top of ground.
 - (4) casing PVC 150 feet
(material) (depth)
 - (size) if telescope see back.
 - (5) screen 7 ft 143 feet
(length) (depth to top)
 - 4" gravel
(size) (material)
 - (6) pump 3/4 17
(HP) (yield gpm)
 - (type power)
 - (7) electric log elect.
(yes or no)
 - (organization running log)
 - (8) how well bottom plugged 4" cp.


DEC 13 1973

DRILLERS REMARKS:

MISS. BD. OF
WATER COMMISSIONERS

If well telescopes please sketch and show depths.

GROUND LEVEL

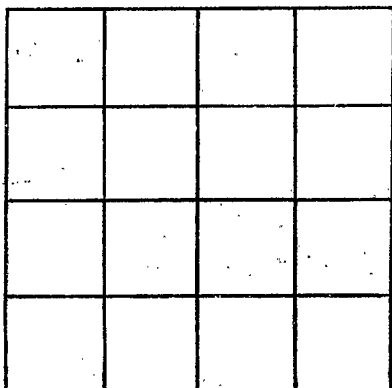

SECTION _____

Please indicate well location X.

ADDITIONAL INFORMATION

If more than one screen,
show locations of each on sketch.