

MARSHALL
E74
12-14-73

MISSISSIPPI
 BOARD OF WATER COMMISSIONERS
 416 North State Street
 Jackson, Mississippi 39201

WATER WELL DRILLERS LOG

CODED

Dec 14 1973
 date well completed

Earl Jones Well Co.
 firm name

Marshall
 county well located

LANDOWNER:

Habe Hill

description of formations encountered

from

to

Red Bamboo Miss. RT

(mailing address)

Topsoil & clay
 sand
 clay
 sand

0 14
 14 62
 62 66
 66 154

WELL LOCATION:

sec 34 T 2 N R 4 E
 2 1/2 S W
 miles NE of Vicksburg
 (distance) (direction) (nearest town)

WELL PURPOSE: Home
 (home, irrigation, municipal, industrial)

WELL COMPLETION DATA:

- (1) diameter (inches) 4"
 - (2) total depth (feet) 154
 - (3) static water level (feet) 98 below top of ground.
 - (4) casing plastic, 148 (material), (depth)
 4" (size) if telescope see back.
 - (5) screen 6" 148 (length), (depth to top)
 4" plastic gravel (size), (material)
 - (6) pump 1/2 16 (HP), (yield gpm)
 Electric (type power)
 - (7) electric log no (yes or no)
- (organization running log)

CODED

(8) how well bottom plugged
 Plastic caps


DRILLERS REMARKS:

DEC 20 1973

MISS. BD. OF
 WATER COMMISSIONERS

If well telescopes please sketch and show depths.

GROUND LEVEL

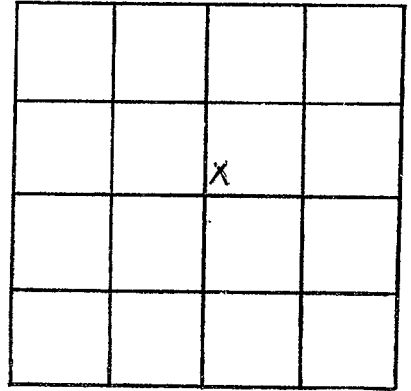

SECTION 34

Please indicate well location X.

ADDITIONAL INFORMATION

If more than one screen,
show locations of each on sketch.