

**MARSHALL**  
**E 76**  
**5-30-74**

MISSISSIPPI  
 BOARD OF WATER COMMISSIONERS  
 416 North State Street  
 Jackson, Mississippi 39201

WATER WELL DRILLERS LOG **CODED**

May 30 1974 date well completed  
 Earl Jones Well Co firm name  
 Marshall county well located

LANDOWNER:  
 John Parker  
 (mailing address)

WELL LOCATION:  
 sec 36 T. 2 N. R. 4 E  
 S. W.  
 3 3/4 miles N.W. of Red Bank  
 (distance) (direction) (nearest town)

WELL PURPOSE: Home  
 (home, irrigation, municipal, industrial)

WELL COMPLETION DATA:

(1) diameter (inches): 4"

(2) total depth (feet): 136

(3) static water level (feet): 82 below top of ground

(4) casing: plastic 136 (material) (depth)  
 4" (size) if telescope see back

(5) screen: 6' 136 (length) (depth to top)  
 4" plastic gravel (size) (material)

(6) pump: 1/2 16 (HP) (yield gpm)  
 Electric (type power)

(7) electric log: no (yes or no)  
 (organization running log)


(8) how well bottom plugged: plastic cap

description of formations encountered	from	to
Topsoil + clay	0	14
sand	14	40
clay	40	65
sand	65	85
clay	85	92
sand	92	142
<b>CODED</b>		
JUN - 8 1974		
MISS. Bd. OF WATER COMMISSIONERS		

DRILLERS REMARKS:

If well telescopes please sketch and show depths.

GROUND LEVEL

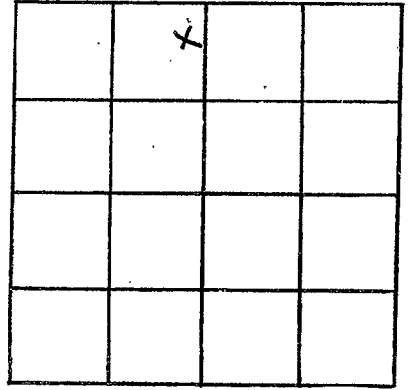

SECTION 36

Please indicate well location X.

ADDITIONAL INFORMATION

If more than one screen,  
show locations of each on sketch.