

MARSHALL

E78

7-23-74

MISSISSIPPI
 BOARD OF WATER COMMISSIONERS
 416 North State Street
 Jackson, Mississippi 39201

CODED

WATER WELL DRILLERS LOG

July 23 1974
(date well completed)

Earl Jones Well Co.
(firm name)

Marshall
(county well located)

LANDOWNER:

Annie Pearl Harris

Victoria Miss

(mailing address)

WELL LOCATION:

sec. 21 T. 2 N. R. 4 E
 S W
3 1/2 miles NW. of Victoria
 (distance) (direction) (nearest town)

WELL PURPOSE: Home
 (home, irrigation, municipal, industrial)

WELL COMPLETION DATA:

- (1) diameter (inches) 4"
- (2) total depth (feet) 100'
- (3) static water level (feet) 70 below above top of ground.
- (4) casing plastic 94'
 (material) (depth)
4" if telescope see back.
 (size)
- (5) screen 6' 94'
 (length) (depth to top)
4" plastic gravel
 (size) (material)
- (6) pump 1/2 15
 (HP) (yield gpm)
Electric
 (type power)
- (7) electric log no
 (yes or no)

(organization running log)

(8) how well bottom plugged
plastic cap

description of formations encountered

from

to

Topsoil and clay

0 10

sand

10 22

clay

22 40

sand


40 65

clay

65 72

sand

72 100

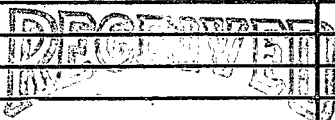


AUG 21 1974

DRILLERS REMARKS:

MISS. BD. OF WATER COMM

If well telescopes please sketch and show depths.

GROUND LEVEL

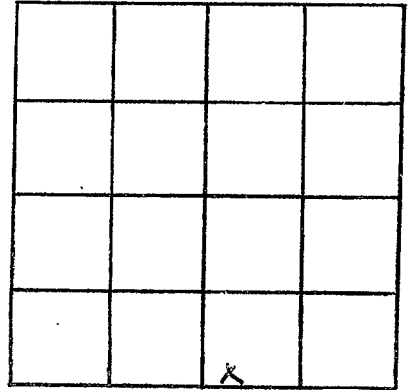

SECTION 21

Please indicate well location X.

ADDITIONAL INFORMATION

If more than one screen,
show locations of each on sketch.