

Marshall
E 84
6-14-75

MISSISSIPPI
BOARD OF WATER COMMISSIONERS
416 North State Street
Jackson, Mississippi 39201

CODED

WATER WELL DRILLERS LOG

June 14 1975 Earl Jones Well Co Marshall
(date well completed) (firm name) (county well located)

LANDOWNER:
Gary J. Michael
Collierville Tenn Rt. 2
(mailing address)

WELL LOCATION:
sec. 3 r. 2 N. R. 4 E 15E
1 1/8 miles S.E. of Cayce
(distance) (direction) (nearest town)

description of formations encountered	from	to
Topsoil + clay	0	17
sand	0	38
clay	38	44
sand	44	90
clay	90	93
sand	93	120

WELL PURPOSE: Home
(home, irrigation, municipal, industrial)

WELL COMPLETION DATA:

(1) diameter (inches) 2"

(2) total depth (feet) 120'

(3) static water level (feet) 40' below top of ground.

(4) casing plastic 114', 2" (material) (depth)
If telescope see back.

(5) screen 6' 114' (length) (depth to top)
2" (size) plastic gravel (material)

(6) pump 1 (HP) 12 (yield gpm)
Electric (type power)

(7) electric log no (yes or no)

(organization running log)

(8) how well bottom plugged plastic cap

CODED


RECEIVED
JUL 14 1975

DRILLERS REMARKS:

MISS. BD. OF WATER COMM.

If well telescopes please sketch and show depths.

GROUND LEVEL

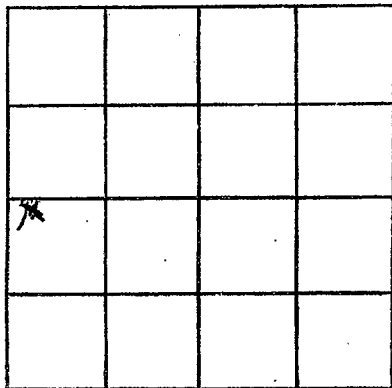

SECTION 3

Please indicate well location X.

ADDITIONAL INFORMATION

If more than one screen, show locations of each on sketch.