

Marshall
E 85
4-26-75

MISSISSIPPI
BOARD OF WATER COMMISSIONERS
416 North State Street
Jackson, Mississippi 39201

CODED

WATER WELL DRILLERS LOG

4-26-1975 *W.A. Mason* *Water Well Contractor* *Marshall*
date well completed firm name county well located


LANDOWNER:	description of formations encountered	from	to
<i>Earnest Wilkins</i>	<i>clay silt</i>	<i>40</i>	<i>10</i>
<i>Victoria Mason</i> (mailing address)	<i>white clay</i>	<i>10</i>	<i>40</i>
WELL LOCATION: sec. <i>33</i> T. <i>2</i> N. R. <i>4</i> E. <i>15E</i> <i>1 1/4</i> miles <i>N</i> of <i>Victoria</i> (distance) (direction) (nearest town)	<i>white sand</i>	<i>40</i>	<i>140</i>
WELL PURPOSE: <i>Home</i> (home, irrigation, municipal, industrial)			
WELL COMPLETION DATA: (1) diameter (inches) <i>4"</i> (2) total depth (feet) <i>170'</i> (3) static water level (feet) <i>100'</i> below top of ground. (4) casing <i>Plaster</i> , <i>160'</i> (material) (depth) <i>4"</i> (size) if telescope see back. (5) screen <i>10'</i> , <i>150'</i> (length) (depth to top) <i>4"</i> (size) <i>Plaster</i> (material) (6) pump <i>1/2</i> (HP) <i>7</i> (yield gpm) <i>electric</i> (type power) (7) electric log <i>NO</i> (yes or no) (organization running log)			
(8) how well bottom plugged <i>cap on screen</i>			
DRILLERS REMARKS:			

CODED

RECEIVED
JUL 01 1975

If well telescopes please sketch and show depths.

GROUND LEVEL

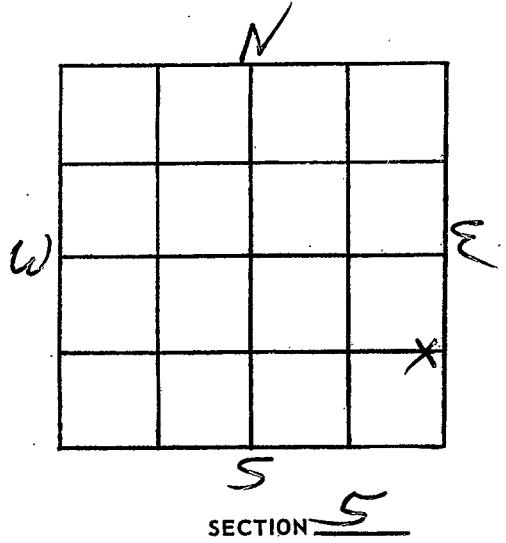

Please indicate well location X.

ADDITIONAL INFORMATION

If more than one screen, show locations of each on sketch.