


If well telescopes, please sketch and show depths.

GROUND LEVEL

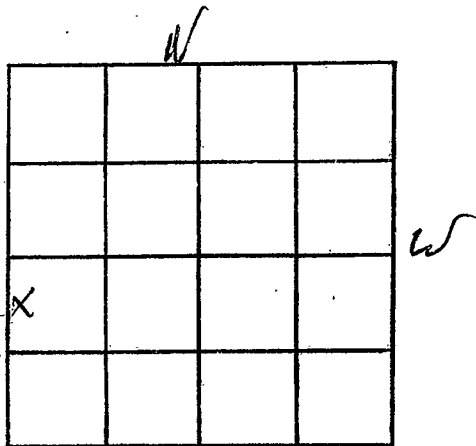

S
SECTION 30-28-5W

Please indicate well location X.

ADDITIONAL INFORMATION

If more than one screen,
show locations of each on sketch.