

Marshall  
E 90  
5-20-75

MISSISSIPPI  
BOARD OF WATER COMMISSIONERS  
416 North State Street  
Jackson, Mississippi 39201

CODED


WATER WELL DRILLERS LOG

5/20 1975 Bel Smith Well Drilling Marshall  
date well completed firm name county well located

LANDOWNER: <u>Calvin Hall</u>	description of formations encountered	from	to
<u>Bethalia, Ark.</u> (mailing address)	<u>top soil</u>	<u>0'</u>	<u>10'</u>
WELL LOCATION: sec. <u>6 T 2 N R 15 E</u> <u>8</u> miles <u>NW</u> of <u>Victoria</u> (distance) (direction) (nearest town)	<u>rocky sand (red)</u>	<u>10'</u>	<u>20'</u>
WELL PURPOSE: <u>None</u> (home, irrigation, municipal, industrial)	<u>reddish colored sand</u>	<u>20'</u>	<u>80'</u>
WELL COMPLETION DATA:	<u>fine sand &amp; streaks</u>	<u>80'</u>	<u>120'</u>
(1) diameter (inches) <u>4"</u>	<u>white clay</u>	<u>80'</u>	<u>120'</u>
(2) total depth (feet) <u>165'</u>	<u>course white sand</u>	<u>120'</u>	<u>165'</u>
(3) static water level (feet) <u>99</u> below top of ground.			
(4) casing <u>plastic</u> , <u>165'</u> (material) (depth)			
(size) if telescope see back.			
(5) screen <u>10'</u> , <u>155'</u> (length) (depth to top)			
<u>4"</u> , <u>plastic</u> (size) (material)			
(6) pump <u>1/3</u> , <u>10</u> (HP) (yield gpm)			
<u>electric</u> (type power)			
(7) electric log <u>no</u> (yes or no)			
(organization running log)			
(8) how well bottom plugged <u>plugged</u>			
DRILLERS REMARKS:	<p>DECLINED</p> <p>AUG 4 1975</p> <p>MISS. RD. OF WATER COMM.</p>		

If well telescopes please sketch and show depths.

GROUND LEVEL

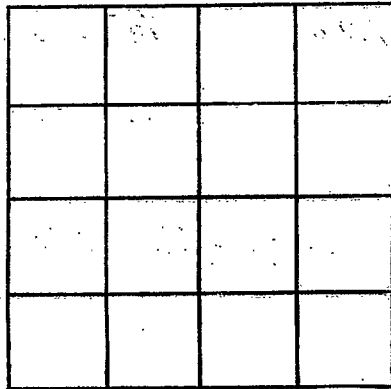

SECTION \_\_\_\_\_

Please indicate well location X.

ADDITIONAL INFORMATION

If more than one screen,  
show locations of each on sketch.