

Marshall  
E 91  
8-15-75

MISSISSIPPI  
BOARD OF WATER COMMISSIONERS  
416 North State Street  
Jackson, Mississippi 39201 **CODED**  
WATER WELL DRILLERS LOG

aug 15 1975 date well completed  
Earl Jones Well Co. firm name  
Marshall county well located

LANDOWNER:  
M. A. Cagle  
Byhalie Miss. Rt.  
(mailing address)

description of formations encountered	from	to
Topsoil + clay	0	18
sand	18	60
clay	60	65
sand	65	75
clay	75	82
sand	82	142

WELL LOCATION:  
sec 27 T 2 N R 4 E 15E  
S W  
2 1/2 miles NE of Victoria  
(distance) (direction) (nearest town)


WELL PURPOSE: Home  
(home, irrigation, municipal, industrial)

- WELL COMPLETION DATA:
- (1) diameter (inches) 4"
  - (2) total depth (feet) 142
  - (3) static water level (feet) \_\_\_\_\_ below above top of ground.
  - (4) casing plastic 132  
(material) (depth)  
4" (size) If telescope see back.
  - (5) screen 10' 132  
(length) (depth to top)  
4" plastic  
(size) (material)
  - (6) pump 3/4 12  
(HP) (yield gpm)  
Electric  
(type power)
  - (7) electric log no  
(yes or no)

(organization running log)

(8) how well bottom plugged  
p loose cap


DRILLERS REMARKS:

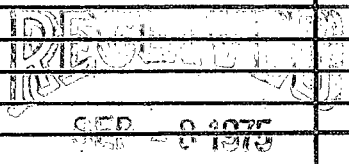

MISS. BD. OF WATER COMM

If well telescopes please sketch and show depths.

GROUND LEVEL

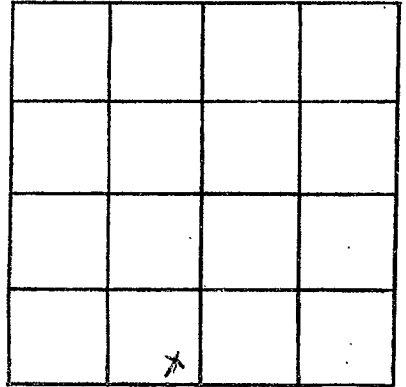

SECTION 27

Please indicate well location X.

ADDITIONAL INFORMATION

If more than one screen,  
show locations of each on sketch.