


If well telescopes please sketch and show depths.

GROUND LEVEL

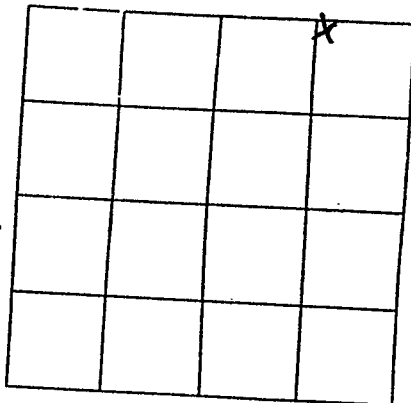

SECTION 27

Please indicate well location X.

| | | | |
|------------------------------------|---------------------------|-----------------------------|-----|
| Pump Capacity (GPM) <u>None</u> | No. of Stages <u>1</u> | Setting Depth <u>46'</u> | FT. |
|------------------------------------|---------------------------|-----------------------------|-----|

PUMP TEST

Well yielded _____ GPM with
a drawdown of _____ ft.
after _____ hours of pumping

LOG DATA

TYPE OF LOG RUN (Circle One):
 Electric, Gamma Ray, Density, No Log Run, Sonic, Neutron.
 Other (Describe) _____

Name of Organization Running Log _____

GEOLOGIC DATA (Office Use Only)

| | | | |
|---------------|---------------|----------------|--------------|
| Surface Elev. | Geologic Unit | Unit Thickness | Depth to Top |
| Subs. SWL | Date | Analysis | Aquifer Test |

Driller's Remarks

draw well - rope and bucket

If more than one screen,
show location of each on sketch.