State W	ell Report			
Mississippi Departmen	t of Environmental Quality	Aquifer:		
Permit #: $0 - 162$ Office of Land :	Office of Land and Water Resources Well #: $\mathcal{E} - 194$			
Driller: Long Caperter P.O. Box 10631 Jackson MS 39289-0631		Well #: <u>C 117</u>		
	Jackson, MS 39289-0631 L. S. Elevation:			
	961-5210 4-6938 (fax)	E-log #:		
(001)55	4-0956 (lax)	E-10g #		
State Law requires that this report be prepared by the license holder responsible for the work and filed with the				
Department at the above address within 30 days of com				
Information on Well Owner (Landowner if borehole is not for a water well)	Well or Bo	rehole Location		
	Latitude: 34 • 55 • 45	" Longitude: 89. • 46 • 03 "		
Owner Name anderson Homes LLC				
Mailing Address: P.O. Bay 539	Method of Lat/Long (circle or	ie): Conventional Survey,		
	USGS quad, Hand-held	GPS, Survey-grade GPS		
	SIN HAINEN 7	Tum 25 Dec like		
Hilly Same no 38635	-JVV 74 INVV 74 SEC			
Helly Spaninge no. 38635 City State Zip Code	Distance Direction <u>4</u> Miles 2-tt	Nearest Town		
Telephone No. (62) 252-3500	4_Miles 2ntl	of sylatia		
1 elephone No. (22) 2 2 2 2 3 2 3 3 3 3				
Well / Bore	hole Data			
Date drilling started: 2-26-07 Date drilling completed: 2-26.	a 7 Hole denth: 90'	Hole diameter:		
Date diffining started. 2-24-27 Date diffining completed. 2-24-				
Location of the source of any surface water used for drilling: Method of dosing and volume of Chlorine used in drilling and devel	Well Wo	ten		
Method of dosing and volume of Chlorine used in drilling and devel	opment: 12 kd the	me to 1000 set word		
Logs run (circle all applicable): No log run Electric Gamma Ray Density Sonic Neutron Other:				
Purpose of borehole (check one): Water Well <u>C</u> Geotechnical/Geological Investigation Ground Source Heat Pump				
Seismic Survey Other (<i>describe</i>)				
If drilling is not related to water well construction, skip the remainder of this block				
Purpose of Well (check one): Home X Industrial Public Supply Irrigation Fish Culture Other:				
If a flowing well, method of flow regulation: Valve Other (describe)				
Static Water Level: <u>30</u> feet above or below (circle one) land surface Date measured: <u>9-26-07</u>				
Method of Measurement (circle one) steel tape electric tape air line other:				
Well depth: $\frac{96'}{10}$ Well grouted to a depth of $\frac{10}{10}$ feet Type of grout (circle one) Neat Cement Bentonite Mix				
Casing length: <u>80</u> feet Casing diameter: <u>4</u> inches Type of casing: <u>PVC</u>				
Screen length: 10 feet Screen diameter: 4 inches Type of screen: PV c Screen slot size:				
Type of completion (circle all applicable) Gravel packed Under		1		
Other (describe):				
Top of lap pipe or reduction in casing:feet. If telescoped or more than one screen, describe on next page				
		RECENTER-SWR-1A		
		OCT 2 6 2007		
		BY: OLWP		

ر ،

8-194

BY: OIWR

Description of formations encountered must be provided for all


wells and boreholes, unless specifically exempted by regulations

The sketch below only required for water wells

ł

<u>ell telescopes, show depths on sketch.</u> Ground Level	Description of Formations Encountered	From (depth)	To (depth)
K		Ground Level	
	Surface Soil	0	20
	med Red Sand	26	.3 6
	met White Sail	36	45
	White Clay White Coose Soul	45	60
	pilite Coase Sort	60	90
			<u> </u>
			1

If more than one screen, show location of each on sketch

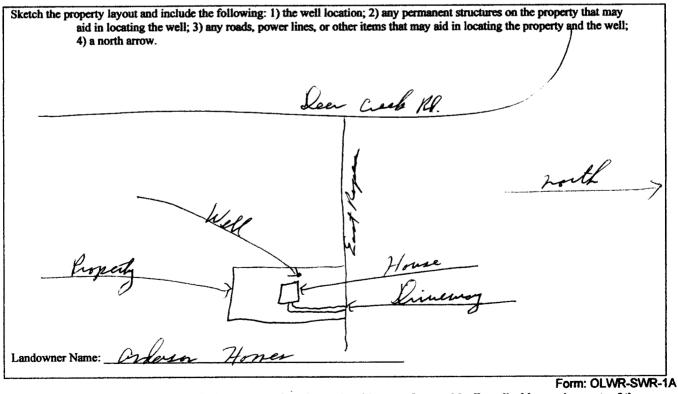

I certify that the well/borehole was drilled, constructed, and completed in accordance with all applicable requirements of the Mississippi Department of Environmental Quality and the Mississippi Department of Health regulations, Damica

laws. Zorry Corps Signature of Licen LARRY CARPENTER G-162 10-5-07

Print Name of Responsible Licensee and License No.

Date

STATE WELL REPORT				
Permit #: $0 - 162$ Mississi	Part 2For Office Use Only:Aquifer:Por Department of Environmental Quality frice of Land and Water Resources P.O. Box 10631 Jackson, MS 39289-0631 (601)961-5210 (601)354-6938 (fax)For Office Use Only: Aquifer: Well #: C - / 9 4 Well #: C - / 9 4 Elevation:			
This part of the report must be completed by a licensed water well contractor or a licensed pump installer. A copy of Part 1 of the report must be attached and both parts filed with the Department at the above address within 30 days of well completion. Well Owner Information				
Owner Name: arkerson Homes a				
Mailing Address: P. 6. 13-4 539	Method of Lat/Long (check one): Conventional Survey,			
Helly Seringe me. 38 City State Zip Telephone No. (664) 252-3500	USGS quad, Hand-held GPS, Survey-grade GPS Code USGS quad, Hand-held GPS, Survey-grade GPS '4'4_Sec7T_2SR_4444 Distance Direction Nearest TownMiles horth of Neglebre			
Pump Type Circle one	Power Type Circle one			
Air Lift Jet Submersit	Diesel Engine Gasoline Engine Natural Gas			
Bucket Piston Turbine	Electric Motor Hand Tractor PTO			
Centrifugal Rotary Flowing	Vell Windmill Other (specify):			
Other (specify): Date Pump Installed: 2 6- 0 7	Horse Power Rating of Motor:			
Rated Pump Capacity:Gallons Per				
Pump Test Data	Method of Measuring Water Level			
Date Well Tested: 7 2 6_ 0 7	Circle one			
Static Water Level (A): Feet Below Land				
Pumping Water Level (B): <u>36</u> Feet Below Land	Surface Other (specify):			
Drawdown [(B) - (A)]:Feet Below Land	Surface For flowing well, measured shut in head:feet			
Test Pumping Rate: Gallons Per	Minute Well yielded <u>17</u> GPM with a drawdown of			
Duration of Pump Test (minimum 4 hours):	_hours feet after hours of pumping			
I HEREBY CERTIFY that the above statements are true to the best of my knowledge. LARRY CARPENTER D-162 Print Name of Pump Installer and License No. (if applicable) Berni Ol and/dale 18				

.

• · · · •

.